

CARD MUST BE TYPED

State of Kansas

CARD MUST BE SIGNED

NOTICE OF INTENTION TO DRILL

(see rules on reverse side)

LC

Expected Spud Date..... 11/23/87
month day year

API Number 15- 003-22,870-00-00
NE SE SE 31 20 20 XX East
720 Sec..... Twp..... S, Rg..... West
500
..... Ft. from South Line of Section
..... Ft. from East Line of Section

OPERATOR: License #..... 6004
Name..... CALDWELL ENTERPRISES
Address..... BOX 42
City/State/Zip..... GARNETT 66032
Contact Person..... GLENN CALDWELL
Phone..... (913) 448-3578

(Note: Locate well on Section Plat on reverse side)
Nearest lease or unit boundary line..... 500 feet
County..... ANDERSON
Lease Name..... CALDWELL ENTERPR Well #..... 1

CONTRACTOR: License #..... 5820
Name..... KENT DRILLING
City/State..... GARNETT, KS. 66032

Ground surface elevation..... feet MSL
Domestic well within 330 feet: _____yes _____no
Municipal well within one mile: _____yes _____no

Well Drilled For: Well Class: Type Equipment:
 Oil _____ Storage Infield Mud Rotary
_____ Gas _____ Inj _____ Pool Ext. _____ Air Rotary
_____ OWWO _____ Expl _____ Wildcat _____ Cable

Depth to bottom of fresh water.....
Depth to bottom of usable water..... 125
Surface pipe by Alternate: 1 _____ 2
Surface pipe planned to be set..... 20

If OWWO: old well info as follows:
Operator.....
Well Name.....
Comp Date..... Old Total Depth.....

Conductor pipe required.....
Projected Total Depth..... 750 feet
Formation..... SQUIRREL

I certify that well will comply with K.S.A. 55-101, et seq., plus eventually plugging hole to KCC specifications.
Date 11/19/87..... Signature of Operator or Agent *Greg Engleman* Title: AS AGENT

For KCC Use:
Conductor Pipe Required..... feet; Minimum Surface Pipe Required..... 20 feet per Alt. 2
This Authorization Expires..... 5-19-88 Approved By..... 11-19-87


EFFECTIVE DATE: 11-24-87

Must be filed with the K.C.C. five (5) days prior to commencing well
This card void if drilling not started within six (6) months of date received by K.C.C.

Important procedures to follow:

1. Notify District office before setting surface casing.
2. Set surface casing by circulating cement to the top.
3. File completion forms ACO-1 with K.C.C. within 120 days of well spud date, following instructions on ACO-1, side 1, and including copies of wireline logs.
4. Notify District office 48 hours prior to old well workover or re-entry.
5. Prior to filing Intent, prepare a proposed plugging plan in case well is D & A, then obtain approval of plan when calling district office prior to setting surface pipe.
6. Submit plugging report (CP-4) to **RECEIVED** after plugging is completed.
STATE CORPORATION COMMISSION
7. Obtain an approved injection docket number before disposing of salt water.
NOV 19 1987
CONSERVATION DIVISION
Wichita, Kansas
8. Notify K.C.C. within 10 days when injection commences or terminates.
9. If an alternate 2 completion, cement in the production pipe from below any usable water to surface within 120 days of spud date.

A Regular Section of Land
1 Mile = 5,280 Ft.

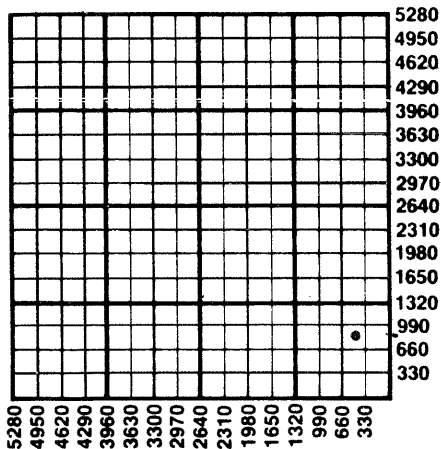

11-19-87

State Corporation Commission of Kansas
Conservation Division
200 Colorado Derby Building
Wichita, Kansas 67202-1212
(316) 263-3238