

CARD MUST BE TYPED

State of Kansas

CARD MUST BE SIGNED

NOTICE OF INTENTION TO DRILL

(see rules on reverse side)

Expected Spud Date..... 10 29 1988
month day year

API Number 15— 003-22,953-00-00 ✓
SE SE SW Sec. 31 Twp. 20 S, Rg. 20 East
40 _____ Ft. from South Line of Section
2910 _____ Ft. from East Line of Section

OPERATOR: License # 6004
Name CALDWELL ENTERPRISES
Address 201 W. 4th
City/State/Zip Garnett, Kansas 66032
Contact Person..... Glenn Caldwell
Phone (913) 448-3578

(Note: Locate well on Section Plat on reverse side)
Nearest lease or unit boundary line 1280 feet
County..... ANDERSON
Lease Name..... CALDWELL FARMS Well #..... 1

CONTRACTOR: License # 5820
Name Kent Drilling Co.
City/State..... Garnett, Kansas 66032

Ground surface elevation feet MSL
Domestic well within 330 feet: _____yes no
Municipal well within one mile: _____yes no
Depth to bottom of fresh water..... 0
Depth to bottom of usable water 100
Surface pipe by Alternate: 1 _____ 2
Surface pipe planned to be set 20
Conductor pipe required 0
Projected Total Depth 750 feet
Formation..... Squirrel

Well Drilled For: Well Class: Type Equipment:
 Oil _____ Storage Infield Mud Rotary
_____ Gas _____ Inj _____ Pool Ext. _____ Air Rotary
_____ OWWO _____ Expl _____ Wildcat _____ Cable

If OWWO: old well info as follows:

Operator
Well Name
Comp Date..... Old Total Depth.....

I certify that well will comply with K.S.A. 55-101, et seq., plus eventually plugging hole to KCC specifications.

Date 10-24-88... Signature of Operator or Agent *Frank [Signature]* Title..... Agent.....

For KCC Use:

Conductor Pipe Required feet; Minimum Surface Pipe Required 20 feet per Alt. (2)
This Authorization Expires..... 4-24-89 Approved By *PHH 10-24-88*


EFFECTIVE DATE: 10-29-88

Must be filed with the K.C.C. five (5) days prior to commencing well
 This card void if drilling not started within six (6) months of date received by K.C.C.

Important procedures to follow:

1. Notify District office before setting surface casing.
2. Set surface casing by circulating cement to the top.
3. File completion forms ACO-1 with K.C.C. within 120 days of well spud date, following instructions on ACO-1, side 1, and including copies of wireline logs.
4. Notify District office 48 hours prior to old well workover or re-entry.
5. Prior to filing Intent, prepare a proposed plugging plan in case well is D & A, then obtain approval of plan when calling district office prior to setting surface pipe.
6. Submit plugging report (CP-4) to K.C.C. after plugging is completed.
7. Obtain an approved injection docket number before disposing of salt water.
8. Notify K.C.C. within 10 days when injection commences or terminates.
9. If an alternate 2 completion, cement in the production pipe from below any usable water to surface within 120 days of spud date.

A Regular Section of Land
1 Mile = 5,280 Ft.

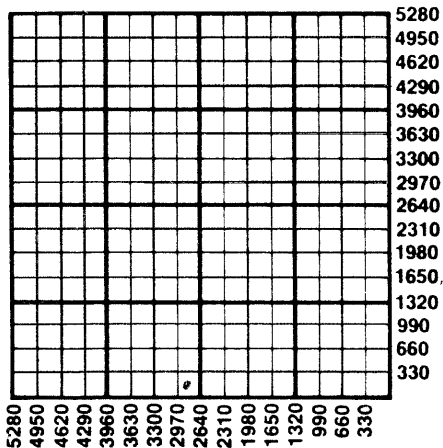

RECEIVED
 STATE DEPARTMENT OF REVENUE
 STATE

10-24-1988
 State Corporation Commission of Kansas
 Conservation Division
 200 Colorado Derby Building
 Wichita, Kansas 67202-1212
 (316) 263-3238

10-24-88