

P CARD MUST BE TYPED

State of Kansas

CARD MUST BE SIGNED ✓

NOTICE OF INTENTION TO DRILL

(see rules on reverse side)

Expected Spud Date. AUGUST 01, 1987
month day year 1:30

API Number 15— 059-24254-00-00

OPERATOR: License # #5297
Name ROBERT GREEN
Address BOX 643
City/State/Zip OTTOWA, KANSAS 66067
Contact Person. ROBERT GREEN
Phone (913) 242-2783

SW NE NE Sec. 24 Twp. 17 S, Rg. 20 East
4171 Ft. from South Line of Section
1162 Ft. from East Line of Section

(Note: Locate well on Section Plat on reverse side)

CONTRACTOR: License # 8509
Name EVANS ENERGY DEVELOPMENT, INC.
City/State 401 S. MAIN, OTTOWA, KS 66067

Nearest lease or unit boundary line 1162 feet
County FRANKLIN
Lease Name ALBERT SCHULZ B Well # 1

Well Drilled For: Well Class: Type Equipment:
 Oil Storage Infield Mud Rotary
 Gas Inj Pool Ext. Air Rotary
 OWWO Expl Wildcat Cable

Ground surface elevation feet MSL
Domestic well within 330 feet: yes no
Municipal well within one mile: yes no
Depth to bottom of fresh water
Depth to bottom of usable water 200
Surface pipe by Alternate: 1 2
Surface pipe planned to be set 20
Conductor pipe required
Projected Total Depth 750 feet
Formation SQUIRREL

If OWWO: old well info as follows:

Operator
Well Name
Comp Date Old Total Depth

I certify that well will comply with K.S.A. 55-101, et seq., plus eventually plugging hole to KCC specifications.

Date 8-03-87 Signature of Operator or Agent [Signature] Title AS AGENT

For KCC Use:


Conductor Pipe Required feet; Minimum Surface Pipe Required 20 feet per Alt. 1
This Authorization Expires 2-3-88 Approved By [Signature] 8-3-87

Must be filed with the K.C.C. five (5) days prior to commencing well
This card void if drilling not started within six (6) months of date received by K.C.C.

Important procedures to follow:

1. Notify District office before setting surface casing.
2. Set surface casing by circulating cement to the top.
3. File completion forms ACO-1 with K.C.C. within 120 days of well spud date, following instructions on ACO-1, side 1, and including copies of wireline logs.
4. Notify District office 48 hours prior to old well workover or re-entry.
5. Prior to filing Intent, prepare a proposed plugging plan in case well is D & A, then obtain approval of plan when calling district office prior to setting surface pipe.
6. Submit plugging report (CP-4) to K.C.C. after plugging is completed.
7. Obtain an approved injection docket number before disposing of salt water.
8. Notify K.C.C. within 10 days when injection commences or terminates.
9. If an alternate 2 completion, cement in the production pipe from below any usable water to surface within 120 days of spud date.

A Regular Section of Land
1 Mile = 5,280 Ft.

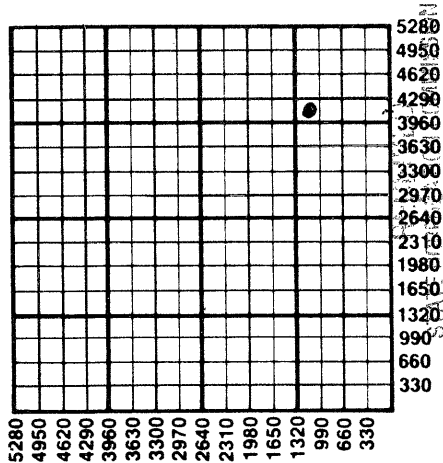

AUG 3 1987

CONSERVATION DIVISION
Wichita, Kansas

8-3-87

State Corporation Commission of Kansas
Conservation Division
200 Colorado Derby Building
Wichita, Kansas 67202-1212
(316) 263-3238