

CARD MUST BE TYPED

State of Kansas
NOTICE OF INTENTION TO DRILL
(see rules on reverse side)

CARD MUST BE SIGNED

Starting Date: 12 27 84
month day year

API Number 15- 059-23, 803-00-00

OPERATOR: License # 5341
Name Glen A. Evans
Address 401 S. Main, Suite 11
City/State/Zip Ottawa, KS 66067
Contact Person Glen Evans
Phone (913) 242-5733

SW East
(location) Sec 25 Twp 17S, Rge 20. West

1800 Ft North from Southeast Corner of Section
4125 Ft West from Southeast Corner of Section
(Note: Locate well on Section Plat on reverse side)

CONTRACTOR: License # 6142
Name Town Oil Drillers
City/State Paola, KS 66071

Nearest lease or unit boundary line 1155 feet.
County Franklin
Lease Name Anderson Well# 1

Well Drilled For: Well Class: Type Equipment:
☒ Oil ☐ Swd ☒ Infield ☒ Mud Rotary
☐ Gas ☐ Inj ☐ Pool Ext. ☐ Air Rotary
☐ OWWO ☐ Expl ☐ Wildcat ☐ Cable

Domestic well within 330 feet: ☐ yes ☒ no
Municipal well within one mile: ☐ yes ☒ no

If OWWO: old well info as follows:

Operator
Well Name
Comp Date Old Total Depth
Projected Total Depth 900 feet
Projected Formation at TD Bartlesville
Expected Producing Formations

Depth to Bottom of fresh water 40 feet
Lowest usable water formation
Depth to Bottom of usable water 200 feet
Surface pipe by Alternate: 1 ☐ 2 ☒
Surface pipe to be set 20 feet
Conductor pipe if any required feet
Ground surface elevation feet MSL
This Authorization Expires 6-26-85
Approved By D-26-84 RCH/KA

I certify that we will comply with K.S.A. 55-101, et seq., plus eventually plugging hole to K.C.C. specifications.

Date 12/17/84 Signature of Operator or Agent

Raquel Robles

Title As. Agent

Form C-1 4/84

mhc/40HE 12/26/84

Must be filed with the K.C.C. five (5) days prior to commencing well
This card void if drilling not started within six (6) months of date received by K.C.C.

Wichita, Kansas
CONSERVATION DIVISION


DEC 26 1984

Section of Land
1 Mile 5,280 Ft.

122684

Important procedures to follow :

1. Notify District office before setting surface casing.
2. Set surface casing by circulating cement to the top.
3. File completion forms ACO-1 with K.C.C. within 90 days of well completion, following instructions on ACO-1, side 1, and including copies of wireline logs.
4. Notify District office 48 hours prior to old well workover or re-entry.
5. Prior to plugging, prepare a plugging plan, then obtain agreement from the appropriate district office for an approved plugging plan.
6. Submit plugging report (CP-4) to K.C.C. after plugging is completed.
7. Obtain an approved injection docket number before disposing of salt water.
8. Notify K.C.C. within 10 days when injection commences or terminates.
9. If an alternate 2 completion, cement in the production pipe from below any usable water to surface within 120 days of spud date.

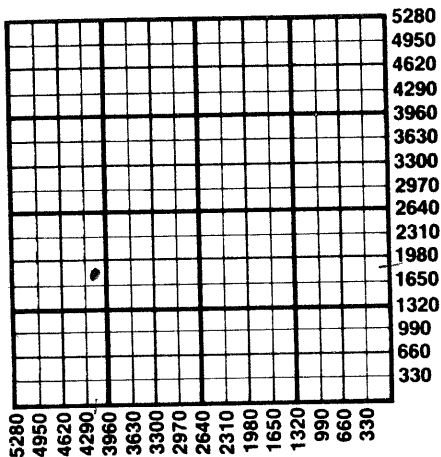

State Corporation Commission of Kansas
Conservation Division
200 Colorado Derby Building
Wichita, Kansas 67202
(316) 263-3238