

CARD MUST BE TYPED

State of Kansas
NOTICE OF INTENTION TO DRILL
 (see rules on reverse side)

CARD MUST BE SIGNED

Starting Date Nov. 7 1985
 month day year 3.40

API Number 15— 059-24094-00-00

OPERATOR: License # 6256
 Name Donald Johnson
 Address Box 125, Route 2
 City/State/Zip Ottawa, KS 66067
 Contact Person Donald Johnson
 Phone 913 755 2790

App. C W2 SE SW Sec. 5 Twp. 17 S, Rg. 21
 670 Ft. from South Line of Section
 3765 Ft. from East Line of Section

(Note: Locate well on Section Plat on reverse side)

CONTRACTOR: License # 5666
 Name Finchs Drilling Co., Inc.
 Box 125, R. 2, Ottawa, KS 66067
 City/State

Well Drilled For: Well Class: Type Equipment:
☒ Oil ☐ SWD ☒ Infield ☒ Mud Rotary
☐ Gas ☐ Inj ☐ Pool Ext. ☐ Air Rotary
☐ OWWO ☐ Expl ☐ Wildcat ☐ Cable

If OWWO: old well info as follows:

Operator
 Well Name
 Comp Date Old Total Depth.....

I certify that well will comply with K.S.A. 55-101, et seq., plus eventually plugging hole to KCC specifications.

cementing will be done immediately upon setting production casing.

Date 11/4/85 Signature of Operator or Agent Elaine Johnson Title as agent

For KCC Use:

Conductor Pipe Required feet; Minimum Surface Pipe Required feet per Alt. 1 2

This Authorization Expires 5-4-86 Approved By 11-4-85

Nearest lease or unit boundary line 670 feet
 County Franklin
 Lease Name Masenthin Well # 4
 Ground surface elevation feet MSL
 Domestic well within 330 feet: yes ☒ no
 Municipal well within one mile: yes ☒ no
 Surface pipe by Alternate: 1 2 ☒
 Depth to bottom of fresh water 100
 Depth to bottom of usable water 200
 Surface pipe planned to be set 20
 Projected Total Depth 750 feet
 Formation Squirrel


felt/KCC
 11/4/85

Must be filed with the K.C.C. five (5) days prior to commencing well
This card void if drilling not started within six (6) months of date received by K.C.C.

Important procedures to follow:

1. Notify District office before setting surface casing.
2. Set surface casing by circulating cement to the top.
3. File completion forms ACO-1 with K.C.C. within 90 days of well completion, following instructions on ACO-1, side 1, and including copies of wireline logs.
4. Notify District office 48 hours prior to old well workover or re-entry.
5. Prior to filing Intent, prepare a proposed plugging plan in case well is D & A, then obtain approval of plan when calling district office prior to setting surface pipe.
6. Submit plugging report (CP-4) to K.C.C. after plugging is completed.
7. Obtain an approved injection docket number before disposing of salt water.
8. Notify K.C.C. within 10 days when injection commences or terminates.
9. If an alternate 2 completion, cement in the production pipe from below any usable water to surface within 120 days of spud date.

A Regular Section of Land
1 Mile = 5,280 Ft.

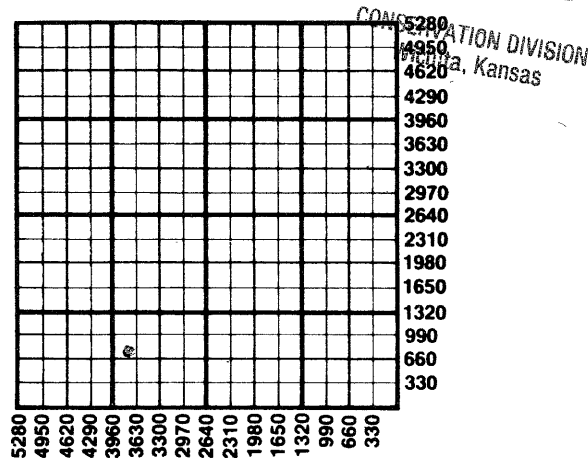

State Corporation Commission of Kansas
Conservation Division
200 Colorado Derby Building
Wichita, Kansas 67202
(316) 263-3238