

RECEIVED

MAY 30 2006

Form C-1  
December 2002

KANSAS CORPORATION COMMISSION  
OIL & GAS CONSERVATION DIVISION

For KCC Use:  
Effective Date: 6-13-06  
District # 3  
SGA?  Yes  No

NOTICE OF INTENT TO DRILL KCC WICHITA

Form must be Typed  
Form must be Signed  
All blanks must be Filled

Must be approved by KCC five (5) days prior to commencing well

Expected Spud Date ASAP  
month day year

Spot NE NE NE Sec. 8 Twp. 28 S. R. 23  East  West  
330 feet from  N /  S Line of Section  
330 feet from  E /  W Line of Section  
Is SECTION  Regular  Irregular?

OPERATOR: License# 33366  
Name: Charles D. Roye  
Address: P.O. Box 191  
City/State/Zip: Girard, KS 66743  
Contact Person: Marvin Strobel  
Phone: 620-362-4906

(Note: Locate well on the Section Plat on reverse side)  
County: Crawford  
Lease Name: Troike Well #: 8-1  
Field Name: wildcat

CONTRACTOR: License# 33374  
Name: L S Well Service (Jim Lorenz)

Is this a Prorated / Spaced Field?  Yes  No  
Target Information(s): Mississippi Lime  
Nearest Lease or unit boundary: 330'

Well Drilled For:  Oil  Enh Rec  Infield  Mud Rotary  
 Gas  Storage  Pool Ext.  Air Rotary  
 CWO  Disposal  Wildcat  Cable  
 Seismic; # of Holes  Other  
 Other

Ground Surface Elevation: 990' feet MSL  
Water well within one-quarter mile:  Yes  No  
Public water supply well within one mile:  Yes  No  
Depth to bottom of fresh water: 1000+  
Depth to bottom of usable water: 1000+

If OWWO: old well information as follows:  
Operator: \_\_\_\_\_  
Well Name: \_\_\_\_\_  
Original Completion Date: \_\_\_\_\_ Original Total Depth: \_\_\_\_\_

Surface Pipe by Alternate:  1  2  
Length of Surface Pipe Planned to be set: 20'  
Length of Conductor Pipe required: none  
Projected Total Depth: 720'  
Formation at Total Depth: Miss. Lime

Directional, Deviated or Horizontal wellbore?  Yes  No  
If Yes, true vertical depth: \_\_\_\_\_  
Bottom Hole Location: \_\_\_\_\_  
KCC DKT #: \_\_\_\_\_

Water Source for Drilling Operations:  
 Well  Farm Pond Other Air  
DWR Permit #: \_\_\_\_\_  
(Note: Apply for Permit with DWR )

Will Cores be taken?  Yes  No  
If Yes, proposed zone: \_\_\_\_\_

AFFIDAVIT

The undersigned hereby affirms that the drilling, completion and eventual plugging of this well will comply with K.S.A. 55 et. seq.  
It is agreed that the following minimum requirements will be met:

RECEIVED

JUN 07 2006

KCC WICHITA

1. Notify the appropriate district office **prior** to spudding of well;
2. A copy of the approved notice of intent to drill **shall be** posted on each drilling rig;
3. The minimum amount of surface pipe as specified below **shall be set** by circulating cement to the top; in all cases surface pipe **shall be set** through all unconsolidated materials plus a minimum of 20 feet into the underlying formation.
4. If the well is dry hole, an agreement between the operator and the district office on plug length and placement is necessary **prior to plugging**;
5. The appropriate district office will be notified before well is either plugged or production casing is cemented in;
6. If an ALTERNATE II COMPLETION, production pipe shall be cemented from below any usable water to surface within **120 days** of spud date. Or pursuant to Appendix "B" - Eastern Kansas surface casing order #133,891-C, which applies to the KCC District 3 area, alternate II cementing must be completed within 30 days of the spud date or the well shall be plugged. **In all cases, NOTIFY district office** prior to any cementing.

I hereby certify that the statements made herein are true and to the best of my knowledge and belief.

Date: 5-26-06 Signature of Operator or Agent: Charles D. Roye Title: Operator

Remember to:

- File Drill Pit Application (form CDP-1) with Intent to Drill;
- File Completion Form ACO-1 within 120 days of spud date;
- File acreage attribution plat according to field proration orders;
- Notify appropriate district office 48 hours prior to workover or re-entry;
- Submit plugging report (CP-4) after plugging is completed;
- Obtain written approval before disposing or injecting salt water.
- If this permit has expired (See: authorized expiration date) please check the box below and return to the address below.

8 28 23E

For KCC Use ONLY  
API # 15 - 037-21833-0000  
Conductor pipe required None feet  
Minimum surface pipe required 20 feet per Alt. **X2**  
Approved by: RM 6-8-06  
This authorization expires: 12-8-06  
(This authorization void if drilling not started within 6 months of effective date.)  
Spud date: \_\_\_\_\_ Agent: \_\_\_\_\_

Well Not Drilled - Permit Expired  
Signature of Operator or Agent: \_\_\_\_\_  
Date: \_\_\_\_\_

Mail to: KCC - Conservation Division, 130 S. Market - Room 2078, Wichita, Kansas 67202

IN ALL CASES PLOT THE INTENDED WELL ON THE PLAT BELOW

Plat of acreage attributable to a well in a prorated or spaced field

If the intended well is in a prorated or spaced field, please fully complete this side of the form. If the intended well is in a prorated or spaced field complete the plat below showing that the well will be properly located in relationship to other wells producing from the common source of supply. Please show all the wells and within 1 mile of the boundaries of the proposed acreage attribution unit for gas wells and within 1/2 mile of the boundaries of the proposed acreage attribution unit for oil wells.

API No. 15 - 037-21833-0000
Operator: Charles D. Roye
Lease: Troike
Well Number: 8-1
Field: wildcat
Number of Acres attributable to well: 397
QTR / QTR / QTR of acreage: NE - NE - NE



Location of Well: County: Crawford
330 feet from N / S Line of Section
330 feet from E / W Line of Section
Sec. 8 Twp. 28 S. R. 23
East West

Is Section: Regular or Irregular

If Section is Irregular, locate well from nearest corner boundary.
Section corner used: NE NW SE SW

PLAT

(Show location of the well and shade attributable acreage for prorated or spaced wells.)
(Show footage to the nearest lease or unit boundary line.)

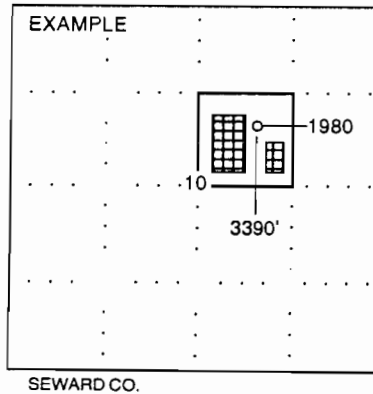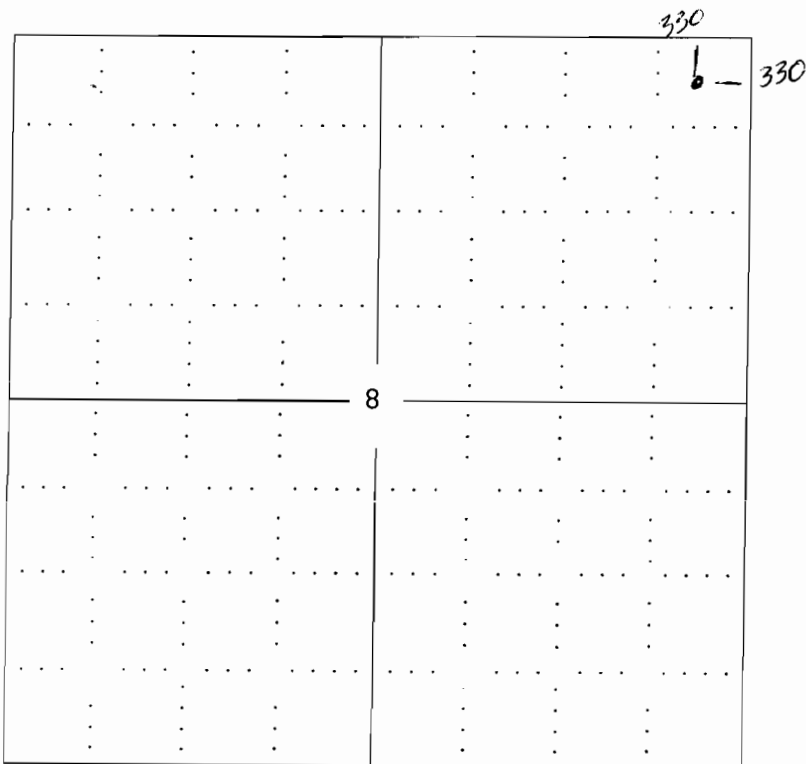

NOTE: In all cases locate the spot of the proposed drilling location.

In plotting the proposed location of the well, you must show:

- 1. The manner in which you are using the depicted plat by identifying section lines, i.e. 1 section, 1 section with 8 surrounding sections, 4 sections, etc.
2. The distance of the proposed drilling location from the section's south / north and east / west.
3. The distance to the nearest lease or unit boundary line.
4. If proposed location is located within a prorated or spaced field a certificate of acreage attribution plat must be attached: (CO-7 for oil wells; CG-8 for gas wells).

KANSAS CORPORATION COMMISSION  
OIL & GAS CONSERVATION DIVISION  
APPLICATION FOR SURFACE POND

RECEIVED  
JUN 07 2006  
KCC WICHITA

Form CDP-1  
January 2001  
Form must be Typed

Submit in Duplicate

Operator Name: <u>Charles D. Roye</u>		License Number: <u>33366</u>
Operator Address: <u>PO Box 191, 211 E Forest Avenue, Girard, KS 66743</u>		
Contact Person: <u>Marvin Strobel</u>	Phone Number: ( <u>620</u> ) <u>724-7445</u> <u>362-4906</u>	
Lease Name: <u>Troike #8-1</u>		Pit Location: <u>NE NE NE</u> ____ Qtr. Sec. <u>8</u> Twp. <u>28S</u> R <u>23</u> <input checked="" type="checkbox"/> E <input type="checkbox"/> W
Type of Pond: ____ Emergency Pit    ____ Treatment Pit ____ Workover Pit <input checked="" type="checkbox"/> Drilling Pit ____ Burn Pit (If WP Supply API No. or Year Drilled)	Pit is: <input checked="" type="checkbox"/> Proposed    ____ Existing If Existing, date constructed: _____ Pit capacity: <u>100</u> (bbls)	<u>330</u> Feet from <u>(N)</u> (circle one) Line of Section <u>330</u> Feet from <u>(E) W</u> (circle one) Line of Section <u>Crawford</u> County
Is the pit located in a Sensitive Ground Water Area? <input type="checkbox"/> Yes <input checked="" type="checkbox"/> No		Chloride concentration: _____ mg/l (For Emergency Pits and Treatment Pits only)
Is the bottom below ground level? <input checked="" type="checkbox"/> Yes <input type="checkbox"/> No	Artificial Liner? <input type="checkbox"/> Yes <input checked="" type="checkbox"/> No	How is the pit lined if a plastic liner is not used? <u>Native Clays</u>
Pit dimensions (all but working pits): <u>10</u> Length (feet) <u>8</u> Width (feet) Depth from ground level to deepest point: <u>4</u> (feet)		
If the pit is lined give a brief description of the liner material, thickness and installation procedure. _____ _____		Describe procedures for periodic maintenance and determining liner integrity, including any special monitoring. _____ _____
Distance to nearest water well within one-mile of pit <u>N/A</u> feet    Depth of water well _____ feet	Depth to shallowest fresh water <u>20</u> feet. Source of information: ____ measured <input checked="" type="checkbox"/> well owner    ____ electric log    ____ KDWR	
<b>Emergency, Treatment and Burn Pits ONLY:</b> Producing Formation: _____ Number of producing wells on lease: _____ Barrels of fluid produced daily: _____ Does the slope from the tank battery allow all spilled fluids to flow into the pond? <input type="checkbox"/> Yes <input type="checkbox"/> No	<b>Drilling and Workover Pits ONLY:</b> Type of material utilized in drilling/workover: <u>Fresh water</u> Number of working pits to be utilized: <u>one</u> Abandonment procedure: <u>Remove and dispose of fluids, cover pit and restore location</u> Drill pits must be closed within 365 days of spud date.	
I hereby certify that the above statements are true and correct to the best of my knowledge and belief.		
<u>6/2/06</u> Date	<u>Charles D Roye</u> Signature of Applicant or Agent	

15-037-21833-0000

KCC OFFICE USE ONLY			
Date Received: <u>6/7/06</u>	Permit Number: _____	Permit Date: <u>6/7/06</u>	Lease Inspection: <input type="checkbox"/> Yes <input checked="" type="checkbox"/> No

Mail to: KCC - Conservation Division, 130 S. Market - Room 2078, Wichita, Kansas 67202