

* API #
CORRECTED *

RECEIVED
AUG 17 2005
KCC WICHITA

IN ALL CASES PLOT THE INTENDED WELL ON THE PLAT BELOW

Show the relationship to other wells or facilities proposed to be serviced by the intended cathodic borehole. Please show all the wells, existing cathodic boreholes, pipelines or facilities within 1/2 mile of the proposed borehole.

* API NO. 15- 057-20571-0000

OPERATOR ANR Pipeline Company
LEASE MP 125
WELL NUMBER #1
FACILITY NAME Trunk 100

LOCATION OF WELL: COUNTY Ford
100 feet from south/north line of section
1570 feet from east/west line of section
SECTION 21 TWP 29S RG 21W

SPOT: QTR/QTR/QTR/QTR OF ACREAGE
 - SE - SW - SE



IS SECTION X REGULAR or IRREGULAR
IF SECTION IS IRREGULAR, LOCATE WELL FROM NEAREST CORNER BOUNDARY.

Section corner used: NE NW X SE SW

PLAT

(Show location of intended cathodic borehole.)

(Show footage from nearest lease, unit or outside section boundary line.)

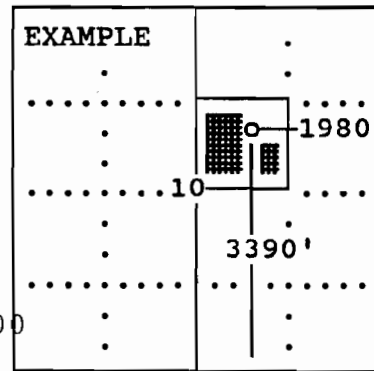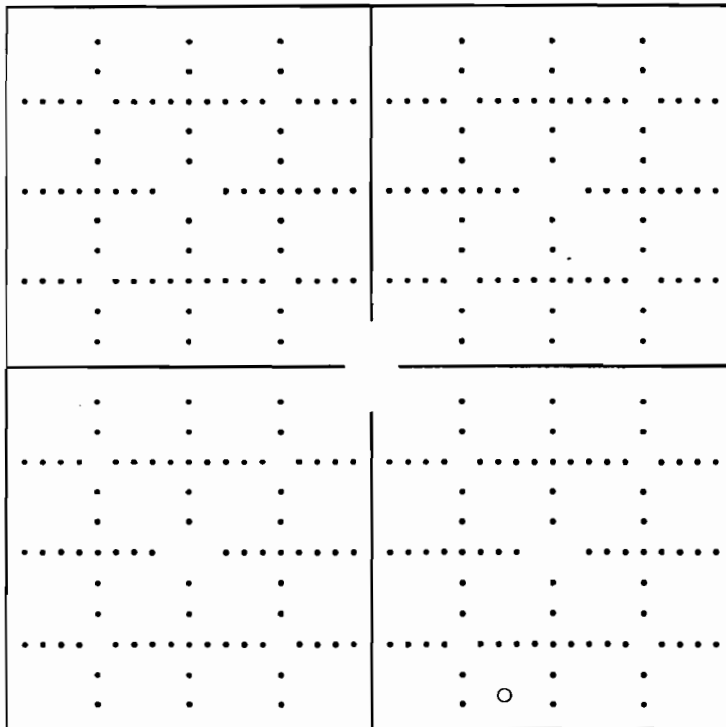

SEWARD CO.

1570

In plotting the proposed location of the well, you must show:

- 1) The manner in which you are using the depicted plat by identifying section lines, i.e. 1 section, 1 section with 8 surrounding sections, 4 sections, etc.;
- 2) the distance of the proposed drilling location from the section's south/north and east/west; and
- 3) the distance to the nearest lease, unit or outside section boundary line.