

CARD MUST BE TYPED

State of Kansas
NOTICE OF INTENTION TO DRILL
(see rules on reverse side)

CARD MUST BE SIGNED

Starting Date: October 25, 1985
month day year

API Number 15- 059-24,089-00-00

OPERATOR: License # 214 5813

NE SE NW/4... Sec .10. Twp .17. S, Rge 21. East West
(location)

Name William Nuss

Address 207 West 37th St.

City/State/Zip Hays, Kansas 67601

Contact Person Don C. Bloomer

Phone 913/878-3497

3505 Ft North from Southeast Corner of Section
2805 Ft West from Southeast Corner of Section
(Note: Locate well on Section Plat on reverse side)

CONTRACTOR: License # 5353

Name Bloomer Service Bloomer Well Serv.

City/State Ottawa, Kansas 66067

Nearest lease or unit boundary line 165 feet.
County Franklin
Lease Name Nuss-Finch Well# 21

Domestic well within 330 feet : yes no
Municipal well within one mile : yes no

Well Drilled For: Well Class: Type Equipment:
 Oil Swd Infield Mud Rotary
 Gas Inj Pool Ext. Air Rotary
 OWWO Expl Wildcat Cable

Depth to Bottom of fresh water 20 feet
Lowest usable water formation N/A
Depth to Bottom of usable water 2.50 feet
Surface pipe by Alternate : 1 2XX
Surface pipe to be set 21' feet
Conductor pipe if any required N/A feet
Ground surface elevation unknown feet MSL
This Authorization Expires 4-23-86
Approved By 10-23-85 *R*

If OWWO: old well info as follows:

Operator
Well Name
Comp Date Old Total Depth
Projected Total Depth 750 feet
Projected Formation at TD Squirrel
Expected Producing Formations Squirrel

I certify that we will comply with K.S.A. 55-101, et seq., plus eventually plugging hole to K.C.C. specifications.

Date 10/21/85 Signature of Operator or Agent

Robert Green
Agent


attorney
Title

RCH/KDHE

Must be filed with the K.C.C. five (5) days prior to commencing well
This card void if drilling not started within six (6) months of date received by K.C.C.

Important procedures to follow :

A Regular Section of Land
1 Mile = 5,280 Ft.

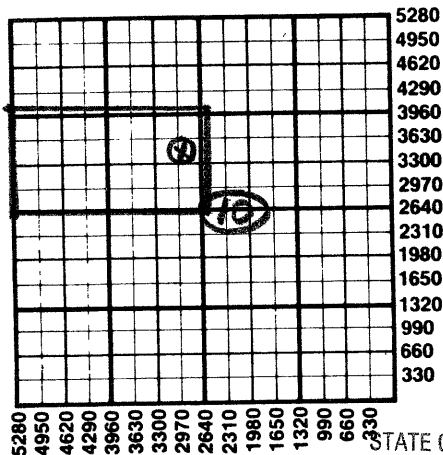

1. Notify District office before setting surface casing.
2. Set surface casing by circulating cement to the top.
3. File completion forms ACO-1 with K.C.C. within 90 days of well completion, following instructions on ACO-1, side 1, and including copies of wireline logs.
4. Notify District office 48 hours prior to old well workover or re-entry.
5. Prior to plugging, prepare a plugging plan, then obtain agreement from the appropriate district office for an approved plugging plan.
6. Submit plugging report (CP-4) to K.C.C. after plugging is completed.
7. Obtain an approved injection docket number before disposing of salt water.
8. Notify K.C.C. within 10 days when injection commences or terminates.
9. If an alternate 2 completion, cement in the production pipe from below any usable water to surface within 120 days of spud date.

RECEIVED

STATE CORPORATION COMMISSION

State Corporation Commission of Kansas
Conservation Division

200 Colorado Derby Building
Wichita, Kansas 67202

(316) 263-3238

1073-85

OCT 23 1985

CONSERVATION DIVISION
Wichita, Kansas