


15-163-00675-00-00

STATE OF KANSAS
STATE CORPORATION COMMISSION
Give All Information Completely
Make Required Affidavit
Mail or Deliver Report to:
Conservation Division
State Corporation Commission
800 Bitting Building
Wichita, Kansas

WELL PLUGGING RECORD

Rooks County. Sec. 4 Twp. 8 Rge. 17 (E) (W)
Location as "NE/CNW $\frac{1}{4}$ /SW $\frac{1}{4}$ " or footage from lines NW NW SE
Lease Owner V. D. Sidey
Lease Name Earl Hunter Well No. 1
Office Address Box 387 Russell, Kansas
Character of Well (completed as Oil, Gas or Dry Hole) Dry
Date well completed 8-7 19 54
Application for plugging filed 8-7 19 54
Application for plugging approved 8-7 19 54
Plugging commenced 8-7 19 54
Plugging completed 8-7 19 54
Reason for abandonment of well or producing formation Dry hole

NORTH

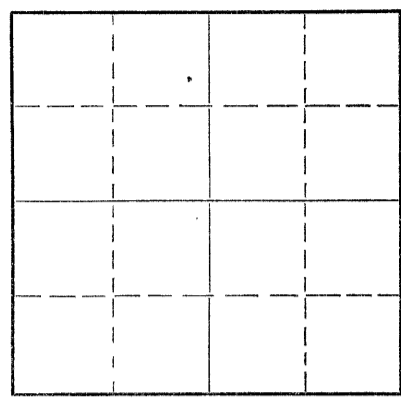

Locate well correctly on above Section Plat

If a producing well is abandoned, date of last production 19
Was permission obtained from the Conservation Division or its agents before plugging was commenced? Yes

Name of Conservation Agent who supervised plugging of this well Eldon Petty Hays, Kansas
Producing formation Depth to top Bottom Total Depth of Well 3425 Feet
Show depth and thickness of all water, oil and gas formations.

OIL, GAS OR WATER RECORDS

CASING RECORD

FORMATION	CONTENT	FROM	TO	SIZE	PUT IN	PULLED OUT
		0	105'	8 5/8"	105'	

Describe in detail the manner in which the well was plugged, indicating where the mud fluid was placed and the method or methods used in introducing it into the hole. If cement or other plugs were used, state the character of same and depth placed, from feet to feet for each plug set.

Hole was filled with heavy mud to bottom of surface pipe 100' Plug was set at 100' and 30 sacks of cement was poured through drill pipe. Hole was then filled to 30' of top with heavy mud and a plug was set- 20 sacks of cement was poured on top of plug bringing cement to bottom of cellar.

(If additional description is necessary, use BACK of this sheet)

Name of Plugging Contractor Sidey Drilling Company
Address Russell, Kansas


STATE OF KANSAS, COUNTY OF RUSSELL, ss.
V. D. Sidey (employee of owner) or (owner or operator) of the above-described well, being first duly sworn on oath, says: That I have knowledge of the facts, statements, and matters herein contained and the log of the above-described well as filed and that the same are true and correct. So help me God.

(Signature) [Signature]
Box 387 Russell, Kansas (Address)

SUBSCRIBED AND SWORN to before me this 19th day of August, 1954

[Signature] Notary Public.

My commission expires September 17, 1956

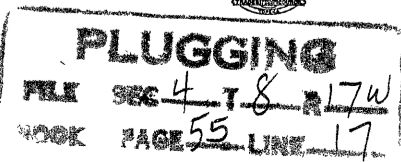

8-21-54

15-1103-00679-00-00

SIDEY DRILLING COMPANY

BUILDING & LOAN BLDG. P. O. BOX 387

RUSSELL, KANSAS

COMPANY V. D. Sidey Oil Company

SEC. 4 T. 8S R. 17W

FARM Earl Hunter NO. 1

LOC. NW NW SE

TOTAL DEPTH 3425'

COUNTY Rocks

COMM. 7-25-54

COMP. 8-7-54

SHOT OR TREATED

CONTRACTOR Sidey Drilling Company

ISSUED

CASING	
20	10
15 1/2	8 1/4 105'
12 1/2	6%
18%	5 5/16

ELEVATION 1945' RB
1940' GL

PRODUCTION

FIGURES INDICATE BOTTOM OF FORMATIONS

0-55	Shale	2150-2185	Lime
55-60	Sand	2185-2305	Lime & Shale
60-105	Shale & Shells	2305-2400	Lime & Shale
105-435	Shale & Shells	2400-2520	Lime & Shale
435-450	Shale & Shells	2520-2670	Lime & Shale
450-470	Sand & Shale	2670-2785	Lime & Shale
470-525	Shale	2785-2895	Lime & Shale
525-615	Sand & Shale	2895-2985	Lime & Shale
615-660	Shale	2985-3070	Lime & Shale
660-703	Sand	3070-3135	Lime & Shale
703-735	Iron & hard sand	3135-3180	Lime & Shale
735-740	Iron & hard sand	3180-3250	Lime & Shale
740-770	Hard sand and sand	3250-3299	Lime & Shale
770-825	Shale & shells	3299-3380	Lime & Shale
825-1005	Sand	3380-3425	Lime & Shale
1005-1295	Red Bed & shells	3425-	TD
1295-1305	Anhydrite		
1305-1335	Anhydrite		
1335-1530	Shale & shells		
1530-1730	Shale & shells		
1730-1760	Lime & Shale		
1760-1960	Lime & Shale		
1960-2095	Lime & shale		
20-95-2150	Lime & Shale		

STATE OF KANSAS, COUNTY OF RUSSELL, ss.

I, V. D. Sidey, of the Sidey Drilling Company, upon oath state that the above and foregoing is a true and correct copy of the log of the Earl Hunter # 1.

V. D. Sidey
V. D. SIDEY

Subscribed and sworn to before me this 18th day of August, 1954.
My Commission Expires: Sept. 17, 1956

Marguerite Bynum
NOTARY PUBLIC

PLUGGING
FILE SEC 4 T 8 R 17W
BOOK PAGE 55 LINE 17

RECEIVED
COMMISSION
CONSERVATION DIVISION
Wichita, Kansas
8-21-54