

CARD MUST BE TYPED

State of Kansas
NOTICE OF INTENTION TO DRILL
(see rules on reverse side)

Extended to 7-25-86
CARD MUST BE SIGNED
1-23-80

Starting Date: *7* / *23* / *85*
month day year

API Number 15- *059-24,004-00-00*

OPERATOR: License # *6142*

CN 1/2 NE $\frac{1}{4}$ SW $\frac{1}{4}$ 21 16 21 East
..... (location) Sec Twp S, Rge West

Name *Town Oil Company*

Address *Route 4*

City/State/Zip *Paola, KS 66071*

Contact Person *Lester Town*

Phone *913-294-2125*

2310
..... Ft North from Southeast Corner of Section
3300 Ft West from Southeast Corner of Section
(Note: Locate well on Section Plat on reverse side)

CONTRACTOR: License # *6152*

Nearest lease or unit boundary line *165*
165' min. distance

County: *Franklin*

Name *Company Tools*

Lease Name *Winkelman* Well# *B-2 ES*

City/State

Domestic well within 330 feet: yes no

Municipal well within one mile: yes no

Well Drilled For: Well Class: Type Equipment:

- Oil Swd Infield Mud Rotary
- Gas Inj Pool Ext. Air Rotary
- OWWO Expl Wildcat Cable

Depth to Bottom of fresh water *8 220* feet

Lowest usable water formation *300*

Depth to Bottom of usable water *200* feet

If OWWO: old well info as follows:

Operator

Well Name

Comp Date Old Total Depth

Projected Total Depth *600'* feet

Surface pipe by Alternate: 1 2

Surface pipe to be set *20* feet

Conductor pipe if any required *none* feet

Ground surface elevation *0* feet MSL

Projected Formation at TD *Bartlesville*

Expected Producing Formations *Bartlesville*

This Authorization Expires *1-25-86*

Approved By *ReA 7-25-85*

I certify that we will comply with K.S.A. 55-101, et seq., plus eventually plugging hole to K.C.C. specifications.

Date .. *7-10-85* ... Signature of Operator or Agent *Donna Barnhart* Title

Partner Agent

W
0-2

Must be filed with the K.C.C. five (5) days prior to commencing well
This card void if drilling not started within six (6) months of date received by K.C.C.

STATE CORPORATION COMMISSION


JUN 19 1985

Important procedures to follow:

A Regular Section of Land
1 Mile = 5,280 Ft.

CONSERVATION DIVISION
WICHITA, KANSAS

1. Notify District office before setting surface casing.
 2. Set surface casing by circulating cement to the top.
 3. File completion forms ACO-1 with K.C.C. within 90 days of well completion, following instructions on ACO-1, side 1, and including copies of wireline logs.
 4. Notify District office 48 hours prior to old well workover or re-entry.
 5. Prior to plugging, prepare a plugging plan, then obtain agreement from the appropriate district office for an approved plugging plan.
 6. Submit plugging report (CP-4) to K.C.C. after plugging is completed.
 7. Obtain an approved injection docket number before disposing of salt water.
 8. Notify K.C.C. within 10 days when injection commences or terminates.
- 90 If an alternate 2 completion, cement in the production pipe from below any usable water to surface within 120 days of spud date.

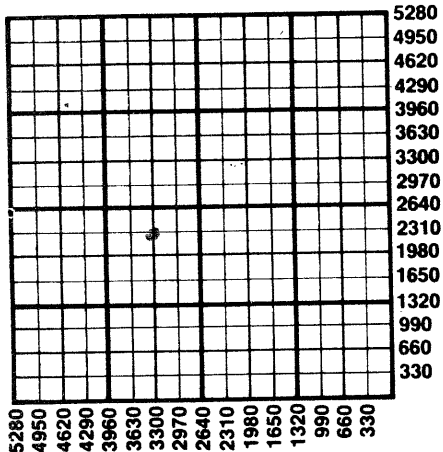

STATE CORPORATION COMMISSION

JUL 25 1985

State Corporation Commission of Kansas
Conservation Division
200 Colorado Derby Building
Wichita, Kansas 67202
(316) 263-3238

Conservation Division
Wichita, Kansas

725-85