

CARD MUST BE TYPED

State of Kansas

CARD MUST BE SIGNED

NOTICE OF INTENTION TO DRILL

(see rules on reverse side)

May 9, 1988

Expected Spud Date.....
month day year

API Number 15— 059-24,330-00-00 *DC*

OPERATOR: License # 9131
Name Jack Sanders & Son
Address R. R. 2 Box 189 C
City/State/Zip Wellsville, Kansas 66092
Contact Person Jack W. or Jackie E. Sanders
Phone 913 8832384

NE 1/4 Sec. 31 Twp. 15 S, Rg. 21 X East
4094 West
358 Ft. from South Line of Section
..... Ft. from East Line of Section

(Note: Locate well on Section Plat on reverse side)

CONTRACTOR: License # 5820
Name Kent Drilling Co.
City/State Garnett, Kansas 66032

Nearest lease or unit boundary line feet
County Franklin
Lease Name Sanders Well # 8

Well Drilled For: Well Class: Type Equipment:
XX Oil ___ Storage X Infield ___ Mud Rotary
___ Gas ___ Inj ___ Pool Ext. ___ Air Rotary
___ OWWO ___ Expl ___ Wildcat ___ Cable

Ground surface elevation 1050 feet MSL
Domestic well within 330 feet: ___ yes X no
Municipal well within one mile: ___ yes X no
Depth to bottom of fresh water. 60 ft.
Depth to bottom of usable water 200 ft.
Surface pipe by Alternate: 1 ___ 2 X
Surface pipe planned to be set 20 ft.
Conductor pipe required
Projected Total Depth ... 800 ft. feet
Formation ... Squirrel

If OWWO: old well info as follows:

Operator
Well Name nb
Comp Date Old Total Depth

I certify that well will comply with K.S.A. 55-101, et seq., plus eventually plugging hole to KCC specifications.
Date 4-18-88 Signature of Operator or Agent Jackie E. Sanders Title Partner

For KCC Use:
Conductor Pipe Required feet; Minimum Surface Pipe Required 20 feet per Alt. X(2)
This Authorization Expires 10-21-88 Approved By JCH 4-21-88


EFFECTIVE DATE: 4-26-88

Must be filed with the K.C.C. five (5) days prior to commencing well
This card void if drilling not started within six (6) months of date received by K.C.C.

Important procedures to follow:

1. Notify District office before setting surface casing.
2. Set surface casing by circulating cement to the top.
3. File completion forms ACO-1 with K.C.C. within 120 days of well spud date, following instructions on ACO-1, side 1, and including copies of wireline logs.
4. Notify District office 48 hours prior to old well workover or re-entry.
5. Prior to filing Intent, prepare a proposed plugging plan in case well is D & A, then obtain approval of plan when calling district office prior to setting surface pipe.
6. Submit plugging report (CP-4) to K.C.C. after plugging is completed.
7. Obtain an approved injection docket number before disposing of salt water.
8. Notify K.C.C. within 10 days when injection commences or terminates.
9. If an alternate 2 completion, cement in the production pipe from below any usable water to surface within 120 days of spud date.

A Regular Section of Land 1 Mile = 5,280 Ft.

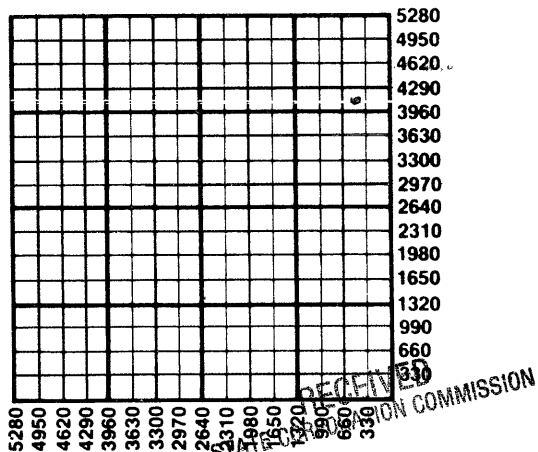

APR 21 1988
421-88
CONSERVATION DIVISION
Wichita, Kansas

State Corporation Commission of Kansas
Conservation Division
200 Colorado Derby Building
Wichita, Kansas 67202-1212
(316) 263-3238