


STATE OF KANSAS
STATE CORPORATION COMMISSION
CONSERVATION DIVISION
P. O. BOX 17027
WICHITA, KANSAS 67217

FORM CP-4

WELL PLUGGING RECORD

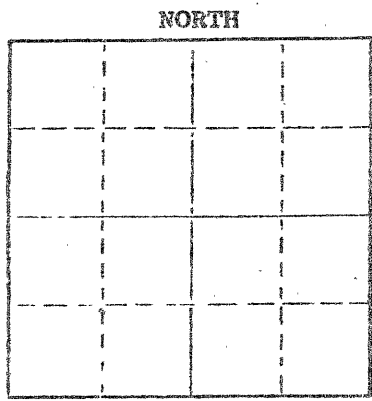

Locate well correctly on above Section Plat

Rooks _____ County. Sec. 19 Twp. 8 Rge. 17 (E) W (W)
Location as "NE/CNW/SE/SW" or footage from lines. SW NW NW
Lease Owner Shields Oil Producers, Inc.
Lease Name Schindler Well No. 1
Office Address Shields Bldg., Russell, Kansas 67665
Character of Well (completed as Oil, Gas or Dry Hole) Dry Hole
Date well completed July 13 1978
Application for plugging filed _____ 1978
Application for plugging approved _____ " 1978
Plugging commenced _____ " 1978
Plugging completed _____ " 1978
Reason for abandonment of well or producing formation Dry Hole

If a producing well is abandoned, date of last production _____ 19____
Was permission obtained from the Conservation Division or its agents before plugging was commenced? Yes

Name of Conservation Agent who supervised plugging of this well Leo Massey
Producing formation _____ Depth to top _____ Bottom _____ Total Depth of Well 3,412 Feet
Show depth and thickness of all water, oil and gas formations.

OIL, GAS OR WATER RECORDS

CASING RECORD

FORMATION	CONTENT	FROM	TO	SIZE	PUT IN	PULLED OUT
				8 5/8"	245'	Cmtd w/160 sax

Describe in detail the manner in which the well was plugged, indicating where the mud fluid was placed and the method or methods used in introducing it into the hole. If cement or other plugs were used, state the character of same and depth placed, from _____ feet to _____ feet for each plug set.

Fill hole w/heavy mud
Push bridge plug to 550'
Spot 70 sax cement on plug three 4 1/2" drill pipe
Push bridge plug to 240'
Spot 20 sax cement on plug three 4 1/2" drill pipe
Push bridge plug to 40' w/ 1/2 sax hulls on plug
Dump 10 sax cement on plug to cellar
Dump 2 sax cement in rat hole and mouse hole

RECEIVED
STATE CORPORATION COMMISSION
JUL 24 1978
JUL 24 1978
CONSERVATION DIVISION
Wichita, Kansas

(If additional description is necessary, use BACK of this sheet)
Name of Plugging Contractor Shields Drilling Co., Inc.
Address Shields Bldg., Russell, Kansas 67665

STATE OF Kansas COUNTY OF Russell ss.
R. L. Shields

(XXXXXXXXXXXX) or (owner or operator) of the above-described well, being first duly sworn on oath, says: That I have knowledge of the facts, statements, and matters herein contained and the log of the above-described well as filed and that the same are true and correct. So help me God.

(Signature) R. L. Shields
Shields Bldg., Russell, Kansas
(Address)

SUBSCRIBED AND SWORN to before me this 20th day of July, 1978.

My commission expires May 26, 1979
Ruth Phillips
Notary Public.


15-163-20886-
826-00-00
Russell, Kansas

Shields

WELL LOG

Operator: Shields Oil Producers, Inc.
Well: Schindler #1
Commenced: July 6, 1978
Completed: July 13, 1978
Contractor: Shields Drilling Co., Inc.

Well Description: SW NW NW
Sec. 19-8S-17W
Rooks Co., Kansas

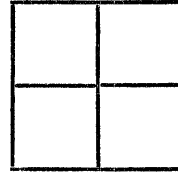

CASING RECORD

Size	Run	Pulled
8 5/8"	245'	Cmtd w/160 sax

Elevation:
Treatment:

Production:

Tops:

..... Figures Indicate Bottom of Formations

Surface soil & post rock	70'
Shale	255'
Shale & Shells	428'
Shale & Sand	1,015'
Redbed & Shale	1,306'
Anhydrite	1,343'
Shale	1,532'
Shale & lime	2,793'
Lime	3,412' RTD

RECEIVED
STATE CORPORATION COMMISSION
JUL 24 1978
JUL 24 1978
CONSERVATION DIVISION
Wichita, Kansas

Notes