

CARD MUST BE TYPED

State of Kansas
NOTICE OF INTENTION TO DRILL
(see rules on reverse side)

CARD MUST BE SIGNED

Starting Date: 6/10/85
month day year

API Number 15- 121-26,554-00-00

OPERATOR: License # 5756

APR. C. S/2 SE SW Sec 12 Twp 17. S, Rge 24
(location) East West

Name Triple-I Energy Corporation

Address 6600 College Blvd. # 310

City/State/Zip Overland Park, KS 66211

Contact Person Debbie Ballard

Phone 913-345-8000

495 Ft North from Southeast Corner of Section

3300 Ft West from Southeast Corner of Section

(Note: Locate well on Section Plat on reverse side)

CONTRACTOR: License # 5678

Nearest lease or unit boundary line 360 feet.

County Miami

Lease Name Burris A Well # 14-T

Domestic well within 330 feet: yes no

Municipal well within one mile: yes no

Name Harold Brady

City/State Paola, KS 66071

Well Drilled For: Well Class: Type Equipment:

- Oil Swd Infield Mud Rotary
- Gas Inj Pool Ext. Air Rotary
- OWWO Expl Wildcat Cable

Depth to Bottom of fresh water none ²⁰ feet

Lowest usable water formation Kansas City Group

Depth to Bottom of usable water 300 feet

Surface pipe by Alternate: 1 2

Surface pipe to be set 20 feet

Conductor pipe if any required _____ feet

Ground surface elevation _____ feet MSL

If OWWO: old well info as follows:

This Authorization Expires 12-7-85

Approved By 6-7-85

I certify that we will comply with K.S.A. 55-101, et seq., plus eventually plugging hole to K.C.C. specifications.

Date 6/7/85 Signature of Operator or Agent Susan Arnold

Title As Agent


2M HC/WOHE 6-7-85 Form C-1 4/84

RECEIVED
STATE CORPORATION COMMISSION

Must be filed with the K.C.C. five (5) days prior to commencing well
This card void if drilling not started within six (6) months of date received by K.C.C.

JUN 7 1985

CONS: [unclear]
A Regular Section of Land
1 Mile = 5,280 Ft.

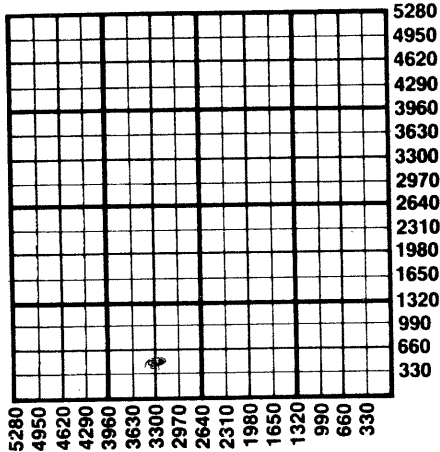

Important procedures to follow:

1. Notify District office before setting surface casing.
2. Set surface casing by circulating cement to the top.
3. File completion forms ACO-1 with K.C.C. within 90 days of well completion, following instructions on ACO-1, side 1, and including copies of wireline logs.
4. Notify District office 48 hours prior to old well workover or re-entry.
5. Prior to plugging, prepare a plugging plan, then obtain agreement from the appropriate district office for an approved plugging plan.
6. Submit plugging report (CP-4) to K.C.C. after plugging is completed.
7. Obtain an approved injection docket number before disposing of salt water.
8. Notify K.C.C. within 10 days when injection commences or terminates.
9. If an alternate 2 completion, cement in the production pipe from below any usable water to surface within 120 days of spud date.

State Corporation Commission of Kansas
Conservation Division
200 Colorado Derby Building
Wichita, Kansas 67202
(316) 263-3238