

CARD MUST BE TYPED

State of Kansas  
**NOTICE OF INTENTION TO DRILL**

CARD MUST BE SIGNED

(see rules on reverse side)

Starting Date: ..... 6 ..... 25 ..... 85 .....  
month day year

API Number 15- 121-26,576-00-00

OPERATOR: License # 57.56  
Name Triple-I Energy Corporation  
Address 6600 College Blvd., #310  
City/State/Zip Overland Park, KS 66211  
Contact Person Debbie Ballard  
Phone (913) 345-8000

11.5  
SW Sec 12 Twp 17 S, Rge 24  East  
 West  
(location)

..... 1.155. Ft North from Southeast Corner of Section  
..... 3.300.. Ft West from Southeast Corner of Section  
(Note: Locate well on Section Plat on reverse side)

CONTRACTOR: License # 4371  
Name Roberts Drilling  
City/State Casper, WY, 82604

Nearest lease or unit boundary line ..... 1.155 ..... feet.  
County Miami  
Lease Name Burris "A" Well# 30WT.

Well Drilled For: Well Class: Type Equipment:  
 Oil  Swd  Infield  Mud Rotary  
 Gas  Inj  Pool Ext.  Air Rotary  
 OWWO  Expl  Wildcat  Cable

Domestic well within 330 feet:  yes  no  
Municipal well within one mile:  yes  no

If OWWO: old well info as follows:

Operator .....  
Well Name .....  
Comp Date ..... Old Total Depth .....  
Projected Total Depth 900 ..... feet  
Projected Formation at TD Mississippi .....  
Expected Producing Formations .....

Depth to Bottom of fresh water 33 ..... feet  
Lowest usable water formation Kansas City Group..  
Depth to Bottom of usable water 300 ..... feet  
Surface pipe by Alternate: 1  2   
Surface pipe to be set 20 ..... feet  
Conductor pipe if any required ..... feet  
Ground surface elevation ..... feet MSL  
This Authorization Expires 12-25-85  
Approved By 6-25-85 RCH for ROHE


I certify that we will comply with K.S.A. 55-101, et seq., plus eventually plugging hole to K.C.C. specifications.

Date 6/25/85 Signature of Operator or Agent *Raquel Gobles* Title As agent

Must be filed with the K.C.C. five (5) days prior to commencing well  
 This card void if drilling not started within six (6) months of date received by K.C.C.

RECEIVED  
 STATE CORPORATION COMMISSION  
 JUN 25 1985  
 88-25-90

A Regular Section of Land  
 1 Mile = 5,280 Ft.

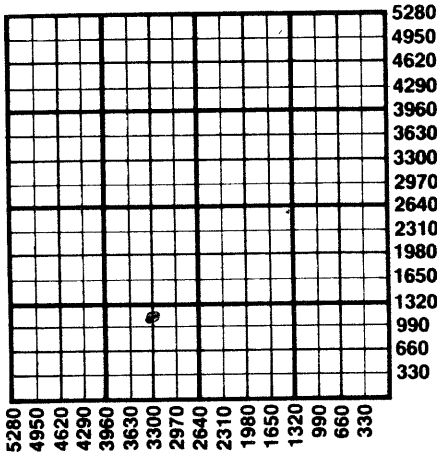

**Important procedures to follow :**

1. Notify District office before setting surface casing.
2. Set surface casing by circulating cement to the top.
3. File completion forms ACO-1 with K.C.C. within 90 days of well completion, following instructions on ACO-1, side 1, and including copies of wireline logs.
4. Notify District office 48 hours prior to old well workover or re-entry.
5. Prior to plugging, prepare a plugging plan, then obtain agreement from the appropriate district office for an approved plugging plan.
6. Submit plugging report (CP-4) to K.C.C. after plugging is completed.
7. Obtain an approved injection docket number before disposing of salt water.
8. Notify K.C.C. within 10 days when injection commences or terminates.
9. If an alternate 2 completion, cement in the production pipe from below any usable water to surface within 120 days of spud date.

State Corporation Commission of Kansas  
 Conservation Division  
 200 Colorado Derby Building  
 Wichita, Kansas 67202  
 (316) 263-3238