

CARD MUST BE TYPED

State of Kansas

CARD MUST BE SIGNED

NOTICE OF INTENTION TO DRILL

(see rules on reverse side)

Starting Date 7-1-87
 month day year

OPERATOR: License # 5969
 Name Elkhound Resources, Inc.
 Address Rt. 1 Box 219B
 City/State/Zip Wellsville, Ks. 66092
 Contact Person Ken Byram
 Phone 913-883-2477

CONTRACTOR: License #
 Name Company Tools
 City/State Wellsville, Ks.

Well Drilled For:	Well Class:	Type Equipment:
☒ Oil	☐ SWD	☒ Infield
☐ Gas	☒ Inj	☐ Pool Ext.
☐ OWWO	☐ Expl	☐ Wildcat
		☐ Cable

If OWWO: old well info as follows:

Operator
 Well Name
 Comp Date Old Total Depth

I certify that well will comply with K.S.A. 55-101, et seq., plus eventually plugging hole to KCC specifications.

Date 6-23-87 Signature of Operator or Agent James Bell Title Manager

For KCC Use:

Conductor Pipe Required _____ feet; Minimum Surface Pipe Required _____ feet per Alt. 20

This Authorization Expires 12-24-87 Approved By Pat 6-24-87

API Number 15—

SW NE SE
W/2 W/2 NW SE Sec. 21 Twp. 17 S, Rg. 21 East
1650 Ft. from South Line of Section
990 Ft. from East Line of Section

(Note: Locate well on Section Plat on reverse side)


Nearest lease or unit boundary line 990 feet
 County Franklin
 Lease Name Little Tullous Well # A15D
 Ground surface elevation na feet MSL
 Domestic well within 330 feet: yes ☒ no
 Municipal well within one mile: yes ☒ no
 Surface pipe by Alternate: 1 2 ☒
 Depth to bottom of fresh water 20
 Depth to bottom of usable water 200
 Surface pipe planned to be set 47
 Projected Total Depth 490 feet
 Formation Squirrel

Must be filed with the K.C.C. five (5) days prior to commencing well
This card void if drilling not started within six (6) months of date received by K.C.C.

Important procedures to follow:

1. Notify District office before setting surface casing.
2. Set surface casing by circulating cement to the top.
3. File completion forms ACO-1 with K.C.C. within 90 days of well completion, following instructions on ACO-1, side 1, and including copies of wireline logs.
4. Notify District office 48 hours prior to old well workover or re-entry.
5. Prior to filing Intent, prepare a proposed plugging plan in case well is D & A, then obtain approval of plan when calling district office prior to setting surface pipe.
6. Submit plugging report (CP-4) to K.C.C. after plugging is completed.
7. Obtain an approved injection docket number before disposing of salt water.
8. Notify K.C.C. within 10 days when injection commences or terminates.
9. If an alternate 2 completion, cement in the production pipe from below any usable water to surface within 120 days of spud date.

A Regular Section of Land
1 Mile = 5,280 Ft.

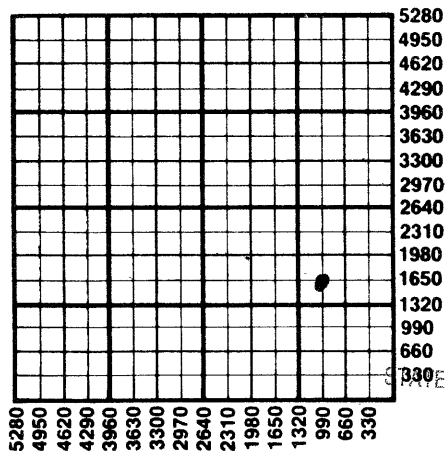

RECEIVED
STATE CORPORATION COMMISSION
JUN 24 1987
CONSERVATION DIVISION
Wichita, Kansas

6-24-87

State Corporation Commission of Kansas
Conservation Division
200 Colorado Derby Building
Wichita, Kansas 67202
(316) 263-3238