

CARD MUST BE TYPED

State of Kansas

CARD MUST BE SIGNED

NOTICE OF INTENTION TO DRILL

EFFECTIVE DATE: 6-22-88 (see rules on reverse side)

Starting Date June 20, 1988 month day year

API Number 15-059-24,351-00-00 DC

OPERATOR: License # 5969
Name ELKHOUND RESOURCES, INC.
Address RR #1 BOX 219B
City/State/Zip WELLSVILLE, KANSAS 66092
Contact Person KENNETH J. BYRAM
Phone (913) 883-2477

SE NW SE Sec. 21 Twp. 17 S, Rg 21 XX East
1485 Ft. from South Line of Section
1485 Ft. from East Line of Section

(Note: Locate well on Section Plat on reverse side)

CONTRACTOR: License #
Name COMPANY TOOLS
City/State

Nearest lease or unit boundary line 1485 feet
County FRANKLIN
Lease Name LITTLE TULLOUS Well # C16D
Ground surface elevation feet MSL

Well Drilled For: Well Class: Type Equipment:
X Oil SWD X Infield X Mud Rotary
Gas Inj Pool Ext Air Rotary
OWWO Expl Wildcat Cable

Domestic well within 330 feet: yes X no
Municipal well within one mile: yes X no
Surface pipe by Alternate: 1 2 X
Depth to bottom of fresh water 20
Depth to bottom of usable water 200
Surface pipe planned to be set 20
Projected Total Depth 525 feet
Formation SQUIRREL

If OWWO: old well info as follows:

Operator
Well Name
Comp Date Old Total Depth

I certify that well will comply with K.S.A. 55-101, et seq., plus eventually plugging hole to KCC specifications.

Date June 14, 1988 Signature of Operator or Agent K. Byram Title President

For KCC Use:


Conductor Pipe Required feet; Minimum Surface Pipe Required 20 feet per Alt. X 2
This Authorization Expires 12-17-88 Approved By P.H. 6-17-88

Must be filed with the K.C.C. five (5) days prior to commencing well  
This card void if drilling not started within six (6) months of date received by K.C.C.

### Important procedures to follow:

1. Notify District office before setting surface casing.
2. Set surface casing by circulating cement to the top.
3. File completion forms ACO-1 with K.C.C. within 90 days of well completion, following instructions on ACO-1, side 1, and including copies of wireline logs.
4. Notify District office 48 hours prior to old well workover or re-entry.
5. Prior to filing Intent, prepare a proposed plugging plan in case well is D & A, then obtain approval of plan when calling district office prior to setting surface pipe.
6. Submit plugging report (CP-4) to K.C.C. after plugging is completed.
7. Obtain an approved injection docket number before disposing of salt water.
8. Notify K.C.C. within 10 days when injection commences or terminates.

### A Regular Section of Land 1 Mile = 5,280 Ft.

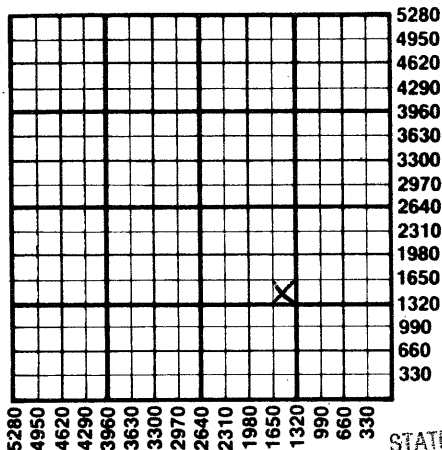

RECEIVED  
STATE CORPORATION COMMISSION

When alternate 2 completion, cement in the production pipe from  
below any usable water to surface within 120 days of spud date.

JUN 17 1980  
6-17-88  
CONSERVATION DIVISION  
Wichita, Kansas

State Corporation Commission of Kansas  
Conservation Division  
200 Colorado Derby Building  
Wichita, Kansas 67202  
(316) 263-3238