

CARD MUST BE TYPED

State of Kansas
NOTICE OF INTENTION TO DRILL
(see rules on reverse side)

CARD MUST BE SIGNED

Starting Date: 3 27 1985
month day year

OPERATOR: License # 7337
Name Ralph A. Mills
Address Route 1, Box 18R
City/State/Zip Lewisburg, Kansas 66053
Contact Person Ralph Mills
Phone 913 837 2702

CONTRACTOR: License # 5786
Name McGown Drilling, Inc.
City/State Box 216, Mound City, Ks. 66056

Well Drilled For:		Well Class:	Type Equipment:
☐ Oil	☐ Swd	☒ Infield	☒ Mud Rotary
☐ Gas	☒ Inj	☐ Pool Ext.	☐ Air Rotary
☐ OWWO	☐ Expl	☐ Wildcat	☐ Cable

If OWWO: old well info as follows:

Operator
Well Name
Comp Date Old Total Depth
Projected Total Depth 400 feet
Projected Formation at TD Peru
Expected Producing Formations

I certify that we will comply with K.S.A. 55-101, et seq., plus eventually plugging hole to K.C.C. specifications.

API Number 15- 121-26,511-00-00

NE/4 Sec 11 Twp 17 S, Rge 24
(location) ☒ East ☐ West

2870 Ft North from Southeast Corner of Section
295 Ft West from Southeast Corner of Section
(Note: Locate well on Section Plat on reverse side)

Nearest lease or unit boundary line 295 feet.
County Miami
Lease Name Mills Well# I-1

Domestic well within 330 feet: ☐ yes ☒ no
Municipal well within one mile: ☐ yes ☒ no

Depth to Bottom of fresh water 40 feet
Lowest usable water formation Kansas City Group
Depth to Bottom of usable water 300 feet

Surface pipe by Alternate: 1 ☐ 2 ☒
Surface pipe to be set 20 feet
Conductor pipe if any required feet
Ground surface elevation feet MSL

This Authorization Expires 9-26-85
Approved By 3-26-85 *[Signature]*


Date .. 3/26/85 Signature of Operator or Agent *Clair D. [Signature]* Title as agent

Must be filed with the K.C.C. five (5) days prior to commencing well
This card void if drilling not started within six (6) months of date received by K.C.C.

RECEIVED
STATE CORPORATION COMMISSION

MAR 26 1985

A Regular Section of Land
1 Mile = 5,280 Ft.

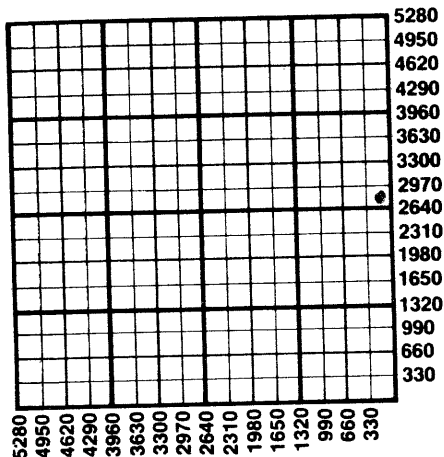

Important procedures to follow :

1. Notify District office before setting surface casing.
2. Set surface casing by circulating cement to the top.
3. File completion forms ACO-1 with K.C.C. within 90 days of well completion, following instructions on ACO-1, side 1, and including copies of wireline logs.
4. Notify District office 48 hours prior to old well workover or re-entry.
5. Prior to plugging, prepare a plugging plan, then obtain agreement from the appropriate district office for an approved plugging plan.
6. Submit plugging report (CP-4) to K.C.C. after plugging is completed.
7. Obtain an approved injection docket number before disposing of salt water.
8. Notify K.C.C. within 10 days when injection commences or terminates.
9. If an alternate 2 completion, cement in the production pipe from below any usable water to surface within 120 days of spud date.

State Corporation Commission of Kansas
Conservation Division
200 Colorado Derby Building
Wichita, Kansas 67202
(316) 263-3238