

CARD MUST BE TYPED

State of Kansas
NOTICE OF INTENTION TO DRILL

CARD MUST BE SIGNED

(see rules on reverse side)

Starting Date: ^{12 8} ~~When approved~~ ⁸⁴
month day year

API Number 15- 121-26,454- / 1
..... NW $\frac{1}{4}$.. Sec 28 Twp 17 S, Rge 24 East
(location) West

OPERATOR: License # 6142
Name Town Oil Co.
Address Rt. 4
City/State/Zip Paola, KS 66071
Contact Person Lester Town
Phone 913-294-2125

4785 Ft North from Southeast Corner of Section
3790 Ft West from Southeast Corner of Section
(Note: Locate well on Section Plat on reverse side)

CONTRACTOR: License # Company Tools
Name
City/State

Nearest lease or unit boundary line 49.5 feet.
County Miami
Lease Name Schooler Well# 2

Well Drilled For: Well Class: Type Equipment:
 Oil Swd Infield Mud Rotary
 Gas Inj Pool Ext. Air Rotary
 OWWO Expl Wildcat Cable

Domestic well within 330 feet : yes no
Municipal well within one mile : yes no

If OWWO: old well info as follows:
Operator
Well Name
Comp Date Old Total Depth
Projected Total Depth 700' feet
Projected Formation at TD Bartlesville
Expected Producing Formations Bartlesville

Depth to Bottom of fresh water 0 feet
Lowest usable water formation
Depth to Bottom of usable water 300 feet
Surface pipe by Alternate : 1 2
Surface pipe to be set 20 feet
Conductor pipe if any required none feet
Ground surface elevation feet MSL
This Authorization Expires 6-3-85
Approved By 12-384 R

I certify that we will comply with K.S.A. 55-101, et seq., plus eventually plugging hole to K.C.C. specifications.


Date 11-27-84 Signature of Operator or Agent Donna Barnhart Title Partner Agent

MHC/NOTE 12/3/84

Must be filed with the K.C.C. five (5) days prior to commencing well
This card void if drilling not started within six (6) months of date received by K.C.C.

Important procedures to follow :

**A Regular Section of Land
1 Mile = 5,280 Ft.**

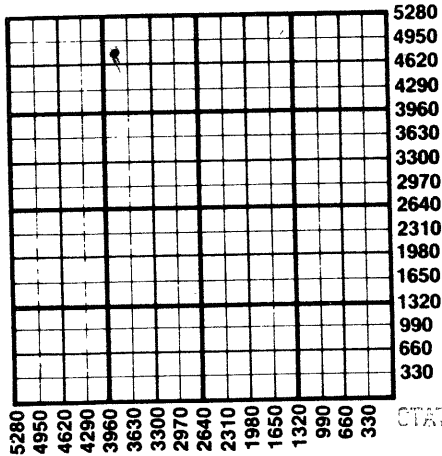

1. Notify District office before setting surface casing.
2. Set surface casing by circulating cement to the top.
3. File completion forms ACO-1 with K.C.C. within 90 days of well completion, following instructions on ACO-1, side 1, and including copies of wireline logs.
4. Notify District office 48 hours prior to old well workover or re-entry.
5. Prior to plugging, prepare a plugging plan, then obtain agreement from the appropriate district office for an approved plugging plan.
6. Submit plugging report (CP-4) to K.C.C. after plugging is completed.
7. Obtain an approved injection docket number before disposing of salt water.
8. Notify K.C.C. within 10 days when injection commences or terminates.
9. If an alternate 2 completion, cement in the production pipe from below any usable water to surface within 120 days of spud date.

STATE CORPORATION COMMISSION

State Corporation Commission of Kansas
Conservation Division
200 Colorado Derby Building
Wichita, Kansas 67202
(316) 263-3238

DEC 03 1934

CONSERVATION DIVISION
Wichita, Kansas