

CARD MUST BE TYPED

State of Kansas

CARD MUST BE SIGNED

NOTICE OF INTENTION TO DRILL

(see rules on reverse side)

Expected Spud Date. SEPTEMBER 2, 1987
month day year

API Number 15- 003-22,834-00-00
X

OPERATOR: License # 9267
Name JRC OIL CORPORATION
Address RURAL ROUTE 1
City/State/Zip GARNETT, KANSAS 66032
Contact Person ROGER KENT
Phone 913-448-5833

NE NW SW Sec. 33 Twp. 20 S, Rg. 21 — East
2183 — West
4347 Ft. from South Line of Section
Ft. from East Line of Section

(Note: Locate well on Section Plat on reverse side)

CONTRACTOR: License # 5820
Name KENT DRILLING
City/State 332 W. 8TH GARNETT, KS 66032

Nearest lease or unit boundary line 170 feet
County ANDERSON

Lease Name KRETCHMER Well # 1
Ground surface elevation 170 feet MSL

Well Drilled For: Well Class: Type Equipment:
 Oil Storage Infield Mud Rotary
 Gas Inj Pool Ext. Air Rotary
 OWWO Expl Wildcat Cable

Domestic well within 330 feet: yes no
Municipal well within one mile: yes no

Depth to bottom of fresh water.
Depth to bottom of usable water 125

Surface pipe by Alternate: 1 2
Surface pipe planned to be set 20

If OWWO: old well info as follows:
Operator
Well Name
Comp Date Old Total Depth.....

Conductor pipe required
Projected Total Depth 750 feet

I certify that well will comply with K.S.A. 55-101, et seq., plus eventually plugging hole to KCC specifications.

Date 9-01-87 Signature of Operator or Agent Greg Engeman Title AS AGENT

Formation SQUIRREL SAND

For KCC Use:

Conductor Pipe Required feet; Minimum Surface Pipe Required 20 feet per Alt. ②

This Authorization Expires 3-6-88 Approved By 9-1-87 Red


Effective Date: 9-6-87

Must be filed with the K.C.C. five (5) days prior to commencing well
This card void if drilling not started within six (6) months of date received by K.C.C.

Important procedures to follow:

1. Notify District office before setting surface casing.
2. Set surface casing by circulating cement to the top.
3. File completion forms ACO-1 with K.C.C. within 120 days of well spud date, following instructions on ACO-1, side 1, and including copies of wireline logs.
4. Notify District office 48 hours prior to old well workover or re-entry.
5. Prior to filing Intent, prepare a proposed plugging plan in case well is D & A, then obtain approval of plan when calling district office prior to setting surface pipe.
6. Submit plugging report (CP-4) to K.C.C. after plugging is completed.
7. Obtain an approved injection docket number before disposing of salt water.
8. Notify K.C.C. within 10 days when injection commences or terminates.
9. If an alternate 2 completion cement in the production pipe from below any usable water to surface within 120 days of spud date.

**A Regular Section of Land
1 Mile = 5,280 Ft.**

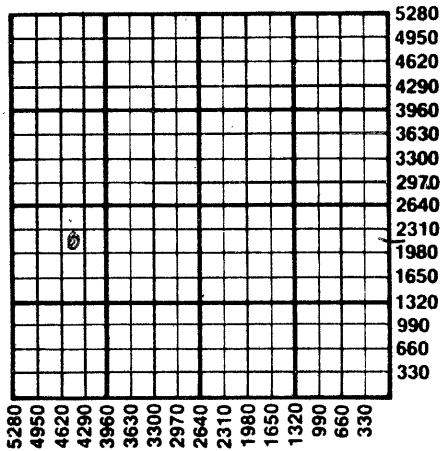

RECEIVED
STATE CORPORATE COMMISSION
SEP 1 1987
State Corporation Commission of Kansas
Conservation Division
200 Colorado Derby Building
Wichita, Kansas 67202-1212
(916) 263-3238
Wichita, Kansas

9-1-87