

CARD MUST BE TYPED

State of Kansas

CARD MUST BE SIGNED

NOTICE OF INTENTION TO DRILL

(see rules on reverse side)

Starting Date July 10 1986 month day year

API Number 15-003-22,755.00-00

OPERATOR: License # 6004

App. NE NE NE

Sec. 13 Twp. 21 S, Rg. 19 East

Name Caldwell Enterprises, Inc.

420 Ft. from South Line of Section

Address Box 42

360 Ft. from East Line of Section

City/State/Zip Garnett, KS 66032

(Note: Locate well on Section Plat on reverse side)

Contact Person Glen Caldwell

Nearest lease or unit boundary line 165 feet

Phone 913 448 3578

County Anderson

CONTRACTOR: License # 5820

Lease Name J.S. Johnson Well # 6

Name Kent Drilling Co.

Ground surface elevation n/a feet MSL

City/State Garnett, KS 66032

Domestic well within 330 feet: yes no

Well Drilled For: Well Class: Type Equipment:

Municipal well within one mile: yes no

X Oil SWD Infield Mud Rotary

Depth to bottom of fresh water 20

Gas Inj X Pool Ext Air Rotary

Depth to bottom of usable water 125

OWWO Expl Wildcat Cable

Surface pipe by Alternate: 1 2 X

If OWWO: old well info as follows:

Surface pipe planned to be set 20

Operator

Conductor pipe required

Well Name

Projected Total Depth 750 feet

Comp Date Old Total Depth

Formation Squirrel

I certify that well will comply with K.S.A. 55-101, et seq., plus eventually plugging hole to KCC specifications.

Date 7/10/86 Signature of Operator or Agent Title as agent

For KCC Use:

Conductor Pipe Required feet; Minimum Surface Pipe Required 20 feet per Alt. X 2


This Authorization Expires JAN 10, 1987 Approved By 7-10-86

Must be filed with the K.C.C. five (5) days prior to commencing well  
This card void if drilling not started within six (6) months of date received by K.C.C.

### Important procedures to follow:

1. Notify District office before setting surface casing.
2. Set surface casing by circulating cement to the top.
3. File completion forms ACO-1 with K.C.C. within 90 days of well completion, following instructions on ACO-1, side 1, and including copies of wireline logs.
4. Notify District office 48 hours prior to old well workover or re-entry.
5. Prior to filing Intent, prepare a proposed plugging plan in case well is D & A, then obtain approval of plan when calling district office prior to setting surface pipe.
6. Submit plugging report (CP-4) to K.C.C. after plugging is completed.
7. Obtain an approved injection docket number before disposing of salt water.
8. Notify K.C.C. within 10 days when injection commences or terminates.

A Regular Section of Land  
1 Mile = 5,280 Ft.

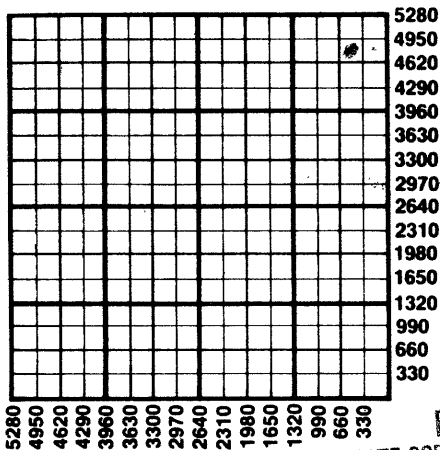

RECEIVED  
STATE CORPORATION COMMISSION

JUL 10 1986

CONSERVATION DIVISION  
Wichita, Kansas

9. If an alternate 2 completion, cement in the production pipe from below any usable water to surface within 120 days of spud date.

State Corporation Commission of Kansas  
Conservation Division  
200 Colorado Derby Building  
Wichita, Kansas 67202  
(316) 263-3238

7-10-86