

CARD MUST BE TYPED

State of Kansas

CARD MUST BE SIGNED ✓

# NOTICE OF INTENTION TO DRILL

(see rules on reverse side)

Expected Spud Date..... APRIL 20, 1987  
month day year *1:15*

API Number 15— 003-22, 796-00-00

OPERATOR: License # 6004  
Name CALDWELL ENTERPRISES, INC.  
Address P. O. BOX 42  
City/State/Zip GARNETT, KS 66032  
Contact Person GLEN CALDWELL  
Phone 913-448-3578

NE SE NW Sec. 13 Twp. 21 S, Rg. 19 X East  
3360 West  
2960 Ft. from South Line of Section  
Ft. from East Line of Section

(Note: Locate well on Section Plat on reverse side)

CONTRACTOR: License # 5820  
Name KENT DRILLING CO.  
City/State 332 W 8th, GARNETT, KS 66032

Nearest lease or unit boundary line 1320 feet  
County ANDERSON  
Lease Name WHEATSTONE Well # 4

Well Drilled For: Well Class: Type Equipment:  
 Oil  Storage  Infield  Mud Rotary  
 Gas  Inj  Pool Ext.  Air Rotary  
 OWWO  Expl  Wildcat  Cable

Ground surface elevation n/a feet MSL  
Domestic well within 330 feet:  yes  no  
Municipal well within one mile:  yes  no

If OWWO: old well info as follows:  
Operator .....  
Well Name .....  
Comp Date ..... Old Total Depth .....

Depth to bottom of fresh water .....  
Depth to bottom of usable water 125  
Surface pipe by Alternate: 20 1 2X  
Surface pipe planned to be set .....  
Conductor pipe required .....  
Projected Total Depth 870 feet  
Formation SQUIRREL

I certify that well will comply with K.S.A. 55-101, et seq., plus eventually plugging hole to KCC specifications.  
Date 4-20-87 Signature of Operator or Agent [Signature] Title AS AGENT

For KCC Use:  
Conductor Pipe Required ..... feet; Minimum Surface Pipe Required ..... feet per Alt. 1 (2)  
This Authorization Expires 10-20-87 Approved By [Signature] 9-20-87

Must be filed with the K.C.C. five (5) days prior to commencing well  
This card void if drilling not started within six (6) months of date received by K.C.C.

4-20-87


RECEIVED  
STATE CORPORATION COMMISSION

Important procedures to follow:

APR 20 1987

A Regular Section of Land  
1 Mile = 5,280 Ft.

Wichita, Kansas

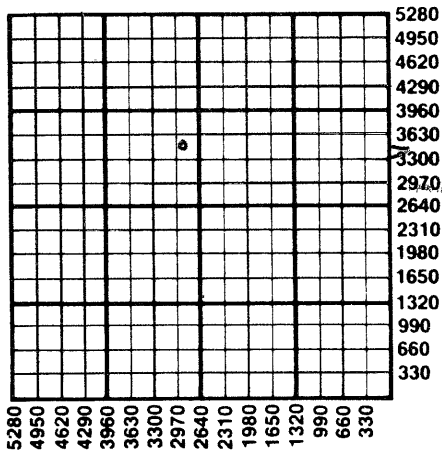

1. Notify District office before setting surface casing.
2. Set surface casing by circulating cement to the top.
3. File completion forms ACO-1 with K.C.C. within 120 days of well spud date, following instructions on ACO-1, side 1, and including copies of wireline logs.
4. Notify District office 48 hours prior to old well workover or re-entry.
5. Prior to filing Intent, prepare a proposed plugging plan in case well is D & A, then obtain approval of plan when calling district office prior to setting surface pipe.
6. Submit plugging report (CP-4) to K.C.C. after plugging is completed.
7. Obtain an approved injection docket number before disposing of salt water.
8. Notify K.C.C. within 10 days when injection commences or terminates.
9. If an alternate 2 completion, cement in the production pipe from below any usable water to surface within 120 days of spud date.

State Corporation Commission of Kansas  
Conservation Division  
200 Colorado Derby Building  
Wichita, Kansas 67202-1212  
(316) 263-3238