

CARD MUST BE TYPED

State of Kansas

CARD MUST BE SIGNED ✓

NOTICE OF INTENTION TO DRILL

(see rules on reverse side)

Expected Spud Date... JULY 30 1987
month day year

API Number 15— 003-22,826 00-00

OPERATOR: License # #6004
Name CALDWELL ENTERPRISES, INC.
Address P.O. BOX 42
City/State/Zip GARNETT, KANSAS 66032
Contact Person GLEN CALDWELL
Phone (913) 448-3578

SW NW Sec... 13 Twp... 21 S, Rg... 19 East
3220 Ft. from South Line of Section
4620 Ft. from East Line of Section

(Note: Locate well on Section Plat on reverse side)

CONTRACTOR: License # 5820
Name KENT DRILLING COMPANY
City/State 332 W 8TH, GARNETT, KS 66032

Nearest lease or unit boundary line 660 feet
County ANDERSON

Lease Name WHETSTONE Well # 7
Ground surface elevation _____ feet MSL

Well Drilled For: Well Class: Type Equipment:
X Oil _____ X Infield X Mud Rotary
_____ Gas _____ Inj _____ Pool Ext. _____ Air Rotary
_____ OWWO _____ Expl _____ Wildcat _____ Cable

Domestic well within 330 feet: _____ yes X no
Municipal well within one mile: _____ yes X no

Depth to bottom of fresh water _____
Depth to bottom of usable water 125

If OWWO: old well info as follows:

Surface pipe by Alternate: _____ 1 _____ 2 X
Surface pipe planned to be set 20

Operator _____
Well Name _____
Comp Date _____ Old Total Depth _____

Conductor pipe required _____
Projected Total Depth 870 feet

I certify that well will comply with K.S.A. 55-101, et seq., plus eventually plugging hole to KCC specifications.

Date 7-24-87 Signature of Operator or Agent Glen Caldwell

Formation SQUIRREL

For KCC Use:

Conductor Pipe Required _____ feet; Minimum Surface Pipe Required 20 feet per Alt. X (2)

This Authorization Expires 1-24-88 Approved By R.H. 7-24-87


Must be filed with the K.C.C. five (5) days prior to commencing well
This card void if drilling not started within six (6) months of date received by K.C.C.

CONFIDENTIAL

Important procedures to follow:

1. Notify District office before setting surface casing.
2. Set surface casing by circulating cement to the top.
3. File completion forms ACO-1 with K.C.C. within 120 days of well spud date, following instructions on ACO-1, side 1, and including copies of wireline logs.
4. Notify District office 48 hours prior to old well workover or re-entry.
5. Prior to filing Intent, prepare a proposed plugging plan in case well is D & A, then obtain approval of plan when calling district office prior to setting surface pipe.
6. Submit plugging report (CP-4) to K.C.C. after plugging is completed.
7. Obtain an approved injection docket number before disposing of salt water.
8. Notify K.C.C. within 10 days when injection commences or terminates.
9. If an alternate 2 completion cement in the production pipe from below any usable water to surface within 120 days of spud date.

A Regular Section of Land 1 Mile = 5,280 Ft.

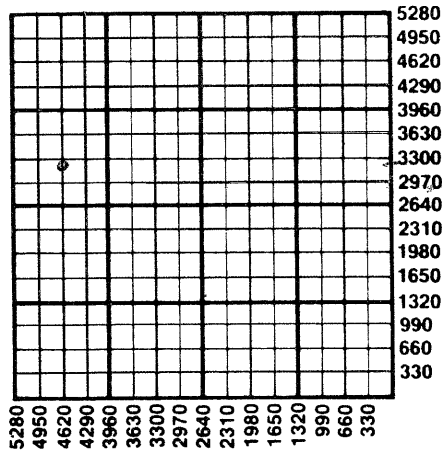

7-24-87

STATE CORPORATION COMMISSION OF KANSAS
Conservation Division
200 Colorado Derby Building
Wichita, Kansas 67202-1212
(316) 263-3238