

WELL LOG

15-179-00159-00-00


COMPANY Aurora Gasoline Company

SEC. 32 T. 7 R. 30W  
LOC. SE SE SE

FARM Farber No. 1

TOTAL DEPTH 4275'  
COMM. 5-25-59 COMP. 6-2-59  
SHOT OR TREATED  
CONTRACTOR Murfin Drilling Company  
ISSUED

COUNTY Sheridan  
KANSAS

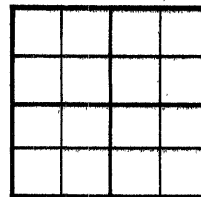

CASING

20 10  
15 8 5/8" @ 311' w/ 165 sxs.  
12 6  
13 5

ELEVATION 2939' K. B.

PRODUCTION D & A

FIGURES INDICATE BOTTOM OF FORMATIONS

311 Surface Hole  
600 Shale  
1680 Shale - Shells  
1830 Shale - Sand  
1850 Hard Sand & Pyrite  
2000 Shale & Sand  
2221 Red Bed & Shale  
2236 Anhydrite  
2250 Red Bed & Shale  
2590 Shale  
2639 Anhydrite  
2850 Shale - Shells  
4045 Shale - Lime  
4275 Lime

TOPS:

Anhydrite 2221  
2nd Anhydrite 2590  
Howard 3661  
Topeka 3768  
Heebner 3988  
Toronto 4012  
Lansing 4027

DST #1 3677-3700


Open 30 min. Weak blow 3 min. Rec.  
15' mud. IF 0#. FF 10#. BHP 907#/20 min.

DST #2 4031-45

Open 30 min. Weak blow 20 min. Rec.  
75' watery mud. FF 0#. IBHP 1260#/20  
min. No final BHP

DST #3 4056-85

Open 30 min. Weak blow 15 min. Rec.  
30' mud. IF 11#. FF 22#. BHP 891#/20 min.

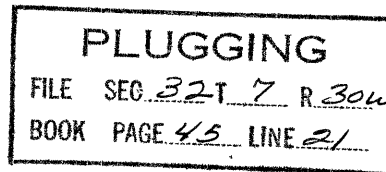

State of Kansas }  
County of Sedgwick } ss:

I, W. R. Murfin of the Murfin Drilling Company  
upon oath state that the above and foregoing is a true and correct copy of the log of the Farber #1 well.

Subscribed and sworn to before me this 11th day of June 19 59

My Commission Expires: March 23, 1960

NOTARY PUBLIC

Donna M. Matzek