

CARD MUST BE TYPED

State of Kansas

CARD MUST BE SIGNED

NOTICE OF INTENTION TO DRILL

(see rules on reverse side)

Expected Spud Date. Unknown
month day year

API Number 15- 059-24,361-00-00 ✓ SIG

OPERATOR: License # 09098

SE SW Sec. 36 Twp. 17S, Rg. 20E X East
330 West

Name McConathy Production Co., Inc.

330 Ft. from South Line of Section

Address 509 Market St., Suite 200

3630 Ft. from East Line of Section

City/State/Zip Shreveport, LA 71101

(Note: Locate well on Section Plat on reverse side)

Contact Person Terry W. Buck

Nearest lease or unit boundary line 330 feet

Phone 318/227-1498

County Franklin

CONTRACTOR: License #

Lease Name R. B. Anderson Well # 3

Name Unknown

Ground surface elevation 1050 feet MSL

City/State

Domestic well within 330 feet: no X yes

Well Drilled For: Well Class: Type Equipment:

Municipal well within one mile: no X yes

Oil Storage Infield Mud Rotary

Depth to bottom of fresh water Unknown

X Gas Inj Pool Ext. X Air Rotary

Depth to bottom of usable water 200

OWWO Expl Wildcat Cable

Surface pipe by Alternate: 1 2 X

IF OWWO: old well info as follows:

Surface pipe planned to be set 21'

Operator

Conductor pipe required None

Well Name

Projected Total Depth 800 feet

Comp Date Old Total Depth

Formation Squirrel-Peru

I certify that well will comply with K.S.A. 55-101, et seq., plus eventually plugging hole to KCC specifications.

Date July 20, 1988 Signature of Operator or Agent Terry W. Buck Title Vice President

For KCC Use:

Conductor Pipe Required _____ feet; Minimum Surface Pipe Required 20' feet per Alt. X (2)

This Authorization Expires 2-2-89 Approved By LKM 8-2-88


EFFECTIVE DATE: 8-7-88

Must be filed with the K.C.C. five (5) days prior to commencing well
This card void if drilling not started within six (6) months of date received by K.C.C.

Important procedures to follow:

1. Notify District office before setting surface casing.
 2. Set surface casing by circulating cement to the top.
 3. File completion forms ACO-1 with K.C.C. within 120 days of well spud date, following instructions on ACO-1, side 1, and including copies of wireline logs.
 4. Notify District office 48 hours prior to old well workover or re-entry.
 5. Prior to filing Intent, prepare a proposed plugging plan in case well is D & A, then obtain approval of plan when calling district office prior to setting surface pipe.
 6. Submit plugging report (CP-4) to K.C.C. after plugging is completed.
 7. Obtain an approved injection docket number before disposing of salt water.
- Notify K.C.C. within 10 days when injection commences or terminates.

A Regular Section of Land
1 Mile = 5,280 Ft.

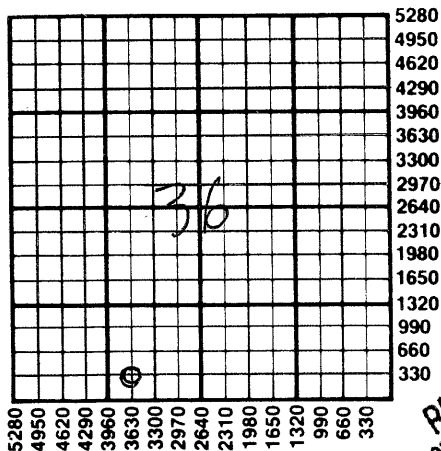

RECEIVED
STATE CORPORATION COMMISSION

AUG - 2 1988

CONSERVATION DIVISION
Wichita, Kansas

J - 2 - JF

State Corporation Commission of Kansas
Conservation Division
200 Colorado Derby Building
Wichita, Kansas 67202-1212
(316) 263-3238