

CARD MUST BE TYPED

State of Kansas
NOTICE OF INTENTION TO DRILL
(see rules on reverse side)

CARD MUST BE SIGNED

Starting Date: 11 15 86
month day year

API Number 15- 059-24129-00-00

OPERATOR: License # 6084
Name McMullin Well Service
Address Rt. 1, Box 192
City/State/Zip Wellsville, Ks. 66092
Contact Person Doug McMullin
Phone 913-883-4343

NW/4 NE/4 Sec 34. Twp 16. S, Rge 21. East West
(location)

5100 Ft North from Southeast Corner of Section
1440 Ft West from Southeast Corner of Section
(Note: Locate well on Section Plat on reverse side)

CONTRACTOR: License #
Name Company tools
City/State

Nearest lease or unit boundary line 180 feet.
County Franklin
Lease Name Vincent Well# 8

Well Drilled For: Well Class: Type Equipment:
 Oil Swd Infield Mud Rotary
 Gas Inj Pool Ext. Air Rotary
 OWWO Expl Wildcat Cable

Domestic well within 330 feet: yes no
Municipal well within one mile: yes no

Depth to Bottom of fresh water 20 feet
Lowest usable water formation

Depth to Bottom of usable water 250 200 feet
Surface pipe by Alternate: 1 2

Surface pipe to be set 20 feet
Conductor pipe if any required

Ground surface elevation feet MSL
This Authorization Expires 7-9-86

Approved By 1-9-86 E

I certify that we will comply with K.S.A. 55-101, et seq., plus eventually plugging hole to K.C.C. specifications.


Date 11/25 Signature of Operator or Agent

Douglas McMullin Title *operator* *fest/kotte*

Must be filed with the K.C.C. five (5) days prior to commencing well
This card void if drilling not started within six (6) months of date received by K.C.C.

Important procedures to follow :

**A Regular Section of Land
1 Mile = 5,280 Ft.**

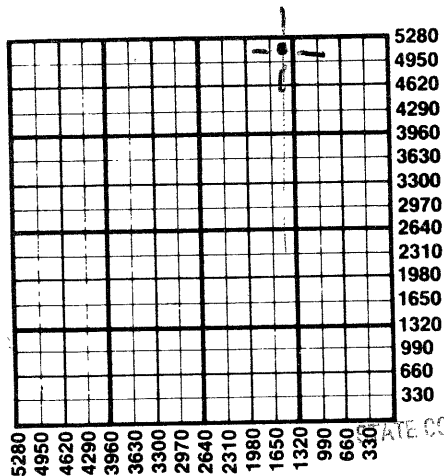

1. Notify District office before setting surface casing.
2. Set surface casing by circulating cement to the top.
3. File completion forms ACO-1 with K.C.C. within 90 days of well completion, following instructions on ACO-1, side 1, and including copies of wireline logs.
4. Notify District office 48 hours prior to old well workover or re-entry.
5. Prior to plugging, prepare a plugging plan, then obtain agreement from the appropriate district office for an approved plugging plan.
6. Submit plugging report (CP-4) to K.C.C. after plugging is completed.
7. Obtain an approved injection docket number before disposing of salt water.
8. Notify K.C.C. within 10 days when injection commences or terminates.
9. If an alternate 2 completion, cement in the production pipe from below any usable water to surface within 120 days of spud date.

State Corporation Commission of Kansas
Conservation Division
200 Colorado Derby Building
Wichita, Kansas 67202
(316) 263-3238

1-9-86

JAN 5 1986

CONS. DIV. ST. CORP. COM. OF KANSAS
WICHITA, KANSAS 67202