

CARD MUST BE TYPED

State of Kansas
NOTICE OF INTENTION TO DRILL
(see rules on reverse side)

CARD MUST BE SIGNED

Starting Date: May 29, 1985
month day year

API Number 15- 059-23,915-0000

OPERATOR: License # 6117
Name Oaks Petroleum Inc.
Address Rt. 3, Box 346
City/State/Zip Paola, Ks. 66071
Contact Person Ray G. Wagner
Phone 913-294-5257

NE $\frac{1}{4}$ SW $\frac{1}{4}$ SW $\frac{1}{4}$ Sec 15 Twp 17 S, Rge 21 East
(location) West

846' Ft North from Southeast Corner of Section
4225.5' Ft West from Southeast Corner of Section
(Note: Locate well on Section Plat on reverse side)

CONTRACTOR: License # 5666
Name Finch Drilling, Inc.
City/State Ottawa, Ks. 66067

Nearest lease or unit boundary line 846' feet.
County Franklin
Lease Name Freeman Well# L0-29

Domestic well within 330 feet: yes no
Municipal well within one mile: yes no

Well Drilled For: Well Class: Type Equipment:
 Oil Swd Infield Mud Rotary
 Gas Inj Pool Ext. Air Rotary
 OWWO Expl Wildcat Cable

Depth to Bottom of fresh water feet
Lowest usable water formation feet
Depth to Bottom of usable water 200' feet
Surface pipe by Alternate: 1 2
Surface pipe to be set 21 feet
Conductor pipe if any required feet
Ground surface elevation 870' feet MSL

This Authorization Expires 11-23-85
Approved By 5-23-85 [Signature]

If OWWO: old well info as follows:
Operator
Well Name
Comp Date Old Total Depth
Projected Total Depth 600' feet
Projected Formation at TD Squirrel
Expected Producing Formations Squirrel

I certify that we will comply with K.S.A. 55-101, et seq., plus eventually plugging hole to K.C.C. specifications.

Date 5/20/85 Signature of Operator or Agent [Signature] Title Manager/Field Operations


Must be filed with the K.C.C. five (5) days prior to commencing well
This card void if drilling not started within six (6) months of date received by K.C.C.

RECEIVED
STATE CORPORATION COMMISSION

5-25-85

A Regular Section of Land
1 Mile = 5,280 Ft.

CONSERVATION DIVISION
Wichita, Kansas

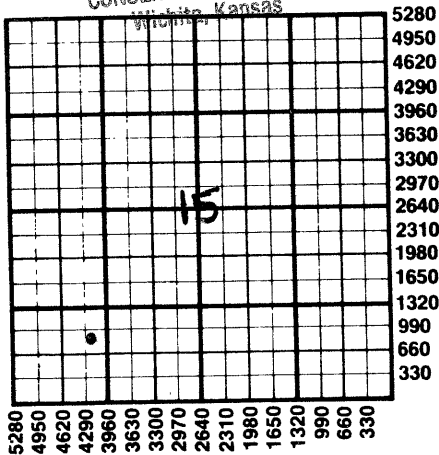

Important procedures to follow:

1. Notify District office before setting surface casing.
2. Set surface casing by circulating cement to the top.
3. File completion forms ACO-1 with K.C.C. within 90 days of well completion, following instructions on ACO-1, side 1, and including copies of wireline logs.
4. Notify District office 48 hours prior to old well workover or re-entry.
5. Prior to plugging, prepare a plugging plan, then obtain agreement from the appropriate district office for an approved plugging plan.
6. Submit plugging report (CP-4) to K.C.C. after plugging is completed.
7. Obtain an approved injection docket number before disposing of salt water.
8. Notify K.C.C. within 10 days when injection commences or terminates.
9. If an alternate 2 completion, cement in the production pipe from below any usable water to surface within 120 days of spud date.

State Corporation Commission of Kansas
Conservation Division
200 Colorado Derby Building
Wichita, Kansas 67202
(316) 263-3238