

CARD MUST BE TYPED

State of Kansas

CARD MUST BE SIGNED

NOTICE OF INTENTION TO DRILL

(see rules on reverse side)

Expected Spud Date.....5-5-87.....
month day year

API Number 15— 059-24,223-00,00

OPERATOR: License #.....6117.....
Name ..Oaks Petroleum, Inc.....
Address ..Rt. 3, Box 346.....
City/State/Zip ..Paola, Ks. 66071.....
Contact Person.....Ray Wagner.....
Phone.....913-294-5257.....

SW NW NE Sec. 15 Twp. 17 S, Rg. 21 East
40.97 Ft. from South Line of Section
2080 Ft. from East Line of Section

(Note: Locate well on Section Plat on reverse side)

CONTRACTOR: License #.....5666.....
NameFinches Drilling, Inc.....
City/State.....Ottawa, Ks.....

Nearest lease or unit boundary line300..... feet
County.....Franklin.....

Lease Name..Miller Graves... Well # 092.....
Ground surface elevation950..... feet MSL

Well Drilled For: Well Class: Type Equipment:
—XOil — Storage Infield Mud Rotary
— Gas — Inj — Pool Ext. — Air Rotary
— OWWO — Expl — Wildcat — Cable

Domestic well within 330 feet: —yes —Xno
Municipal well within one mile: —yes —Xno

Depth to bottom of fresh water.....
Depth to bottom of usable water200.....

If OWWO: old well info as follows:

Surface pipe by Alternate: 21 1— 2
Surface pipe planned to be set

Operator,
Well Name,
Comp Date, Old Total Depth.....

Conductor pipe required

Projected Total Depth7.50..... feet
Formation.....Squirrel.....

I certify that well will comply with K.S.A. 55-101, et seq., plus eventually plugging hole to KCC specifications.

Date 5/1/87..... Signature of Operator or Agent

Title..As Agent.....

For KCC Use:


Conductor Pipe Required feet; Minimum Surface Pipe Required feet per Alt. 20
This Authorization Expires 11-1-87..... Approved By 5-1-87 R

Must be filed with the K.C.C. five (5) days prior to commencing well
This card void if drilling not started within six (6) months of date received by K.C.C.

Important procedures to follow:

1. Notify District office before setting surface casing.
2. Set surface casing by circulating cement to the top.
3. File completion forms ACO-1 with K.C.C. within 120 days of well spud date, following instructions on ACO-1, side 1, and including copies of wireline logs.
4. Notify District office 48 hours prior to old well workover or re-entry.
5. Prior to filing Intent, prepare a proposed plugging plan in case well is D & A, then obtain approval of plan when calling district office prior to setting surface pipe.
6. Submit plugging report (CP-4) to K.C.C. after plugging is completed.
7. Obtain an approved injection docket number before disposing of salt water.
8. Notify K.C.C. within 10 days when injection commences or terminates.

A Regular Section of Land
1 Mile = 5,280 Ft.

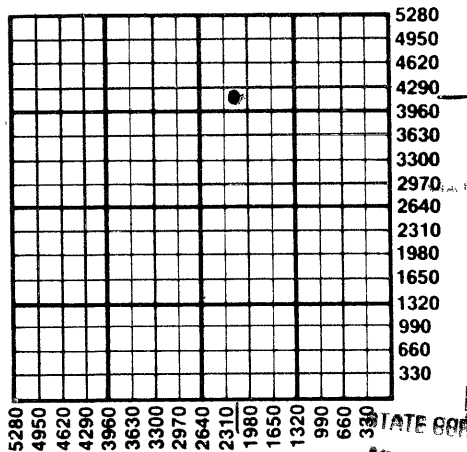

RECEIVED

STATE CORPORATION COMMISSION

MAY 4 1987

CONSERVATION DIVISION
Wichita, Kansas

510-87

If an alternate 2 completion, cement in the production pipe from below any usable water to surface within 120 days of spud date.

State Corporation Commission of Kansas
Conservation Division
200 Colorado Derby Building
Wichita, Kansas 67202-1212
(316) 263-3238