

CARD MUST BE TYPED

State of Kansas

CARD MUST BE SIGNED

NOTICE OF INTENTION TO DRILL

(see rules on reverse side)

Expected Spud Date. JUNE 30, 1987
 month day year

API Number 15— 059-21,648-100-01
 Sec. 16 Twp. 17 S, Rg. 21
☒ East
☐ West

OPERATOR: License # #3032
 Name DEAN MEDLEN
 Address P.O. BOX 36
 City/State/Zip REANTOUL, KS. 66079
 Contact Person DEAN MEDLEN
 Phone 316-878-3445

870 Ft. from South Line of Section
4850 Ft. from East Line of Section

(Note: Locate well on Section Plat on reverse side)

CONTRACTOR: License # 5335
 Name HAWKEYE DRILLING COMPANY
 City/State RR. 2, BOX 73A, WELLSVILLE, KS. 66098

Nearest lease or unit boundary line 430 feet
 County FRANKLIN
 Lease Name CAYLOR Well B-30A
 Ground surface elevation 525 feet MSL

Well Drilled For: Well Class: Type Equipment:
☒ Oil ☐ Storage ☒ Infield ☒ Mud Rotary
☐ Gas ☐ Inj ☐ Pool Ext. ☐ Air Rotary
☒ OWWO ☐ Expl ☐ Wildcat ☐ Cable

Domestic well within 330 feet: ☐ yes ☒ no
 Municipal well within one mile: ☐ yes ☒ no

If OWWO: old well info as follows:

Operator OCELOT OIL CORPORATION
 Well Name CAYLOR B. 30-A
 Comp Date 12-18-80 Old Total Depth 525

Depth to bottom of fresh water 50
 Depth to bottom of usable water 50-200
 Surface pipe by Alternate: 1 ☒
 Surface pipe planned to be set 60
 Conductor pipe required
 Projected Total Depth 525 feet
 Formation SQUIRREL

I certify that well will comply with K.S.A. 55-101, et seq., plus eventually plugging hole to KCC specifications.

Date 6-29-87 Signature of Operator or Agent Greg Engeman Title AS AGENT

For KCC Use:


Conductor Pipe Required 20 feet; Minimum Surface Pipe Required 20 feet per Alt. ☒
 This Authorization Expires 12-29-87 Approved By Post 6-29-87

Must be filed with the K.C.C. five (5) days prior to commencing well
This card void if drilling not started within six (6) months of date received by K.C.C.

Important procedures to follow:

1. Notify District office before setting surface casing.
2. Set surface casing by circulating cement to the top.
3. File completion forms ACO-1 with K.C.C. within 120 days of well spud date, following instructions on ACO-1, side 1, and including copies of wireline logs.
4. Notify District office 48 hours prior to old well workover or re-entry.
5. Prior to filing Intent, prepare a proposed plugging plan in case well is D & A, then obtain approval of plan when calling district office prior to setting surface pipe.
6. Submit plugging report (CP-4) to K.C.C. after plugging is completed.
7. Obtain an approved injection docket number before disposing of salt water.
8. Notify K.C.C. within 10 days when injection commences or terminates.
9. If an alternate 2 completion, cement in the production pipe from below any usable water to surface within 120 days of spud date.

A Regular Section of Land 1 Mile = 5,280 Ft.

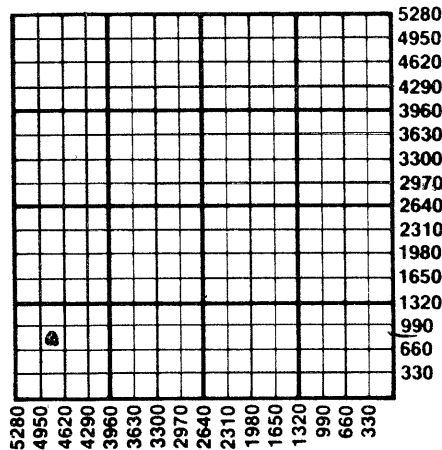

6-29-87

State Corporation Commission of Kansas
Conservation Division
200 Colorado Derby Building
Wichita, Kansas 67202-1212
(316) 263-3238