

KANSAS CORPORATION COMMISSION  
OIL & GAS CONSERVATION DIVISION  
**WELL PLUGGING APPLICATION**  
Please TYPE Form and File ONE Copy

Form CP-1  
September 2003  
This Form must be Typed  
Form must be Signed  
All blanks must be Filled

API # 15 - 093-20352-00-00 (Identifier Number of this well). This must be listed for wells drilled since 1967; if no API # was issued, indicate original spud or completion date spud 11/24/76.

Well Operator: XTO Energy, Inc. KCC License #: 32864  
(Owner / Company Name) (Operator's)

Address: 210 Park Ave., Suite 2350 City: Oklahoma City

State: Oklahoma Zip Code: 73102 Contact Phone: ( 405 ) 319 - 3212

Lease: Masonic Home Well #: 3-2 Sec. 36 Twp. 25 S. R. 36  East  West

NE - NE - NE - SW Spot Location / QQQQ County: Kearny

2520 Feet (in exact footage) From  North /  South (from nearest outside section corner) Line of Section (Not Lease Line)

2540 Feet (in exact footage) From  East /  West (from nearest outside section corner) Line of Section (Not Lease Line)

Check One:  Oil Well  Gas Well  D&A  Cathodic  Water Supply Well  
 SWD Docket # \_\_\_\_\_  ENHR Docket # \_\_\_\_\_  Other: \_\_\_\_\_

Conductor Casing Size: N/A Set at: \_\_\_\_\_ Cemented with: \_\_\_\_\_ Sacks

Surface Casing Size: 8 5/8" Set at: 535 Cemented with: 300 Sacks

Production Casing Size: 5 1/2" Set at: 2999 Cemented with: 700 Sacks

List (ALL) Perforations and Bridgeplug Sets: 2724' - 40', 2770' - 74', 2778' - 82', 2812' - 16', 2828' - 32', 2838' - 46'

Elevation: 3032' ( G.L. /  K.B.) T.D.: 3010' P.B.T.D.: 3006' Anhydrite Depth: 1238'  
(Stone Corral Formation)

Condition of Well:  Good  Poor  Casing Leak  Junk in Hole

Proposed Method of Plugging (attach a separate page if additional space is needed): CIBP @ 2674w/ 2 sx cmt, 40 sx cmt @ csg cut +/- 1000' - 900' (100' plug)  
47.2 yield, 90 sx cmt @ 635' - 435' 106.2 yield, 10 sx cmt @ 34'-4' 11.8 yield Mud weight - minimum 9 ppg, cement weight - minimum 16 ppg

Is Well Log attached to this application as required?  Yes  No Is ACO-1 filed?  Yes  No

If not explain why? Not available Unknown

Plugging of this Well will be done in accordance with K.S.A. 55-101 et. seq. and the Rules and Regulations of the State Corporation Commission.

List Name of Company Representative authorized to be in charge of plugging operations: David Littell or Mark Gosch

Phone: ( 620 ) 355 - 7838

Address: 805 S. Hwy 25 City / State: Lakin, KS 67860

Plugging Contractor: Sargent & Horton Plugging KCC License #: 31151  
(Company Name) (Contractor's)

Address: Rt. 1, Box 49 BA, Tyrone, OK Phone: ( 580 ) 854 - 6515

Proposed Date and Hour of Plugging (if known?): ASAP

Payment of the Plugging Fee (K.A.R. 82-3-118) will be guaranteed by Operator or Agent

Date: 5/31/06 Authorized Operator / Agent: Karen Byers (Signature)

Mail to: KCC - Conservation Division, 130 S. Market - Room 2078, Wichita, Kansas 67202

RECEIVED  
KANSAS CORPORATION COMMISSION

JUN 19 2006

CONSERVATION DIVISION  
WICHITA, KS


DEC 1 1976

12-8-76

DATE

Kearney	36	25s	36w	2520'FSL	2540FWL
COUNTY	S	T	R	LOCATION	
Kansas-Nebraska			3-2	Masonic Home	
OPERATOR			NO.	FARM	3041 gr.
			ELEVATION:		

SCALE: 2"=1mile

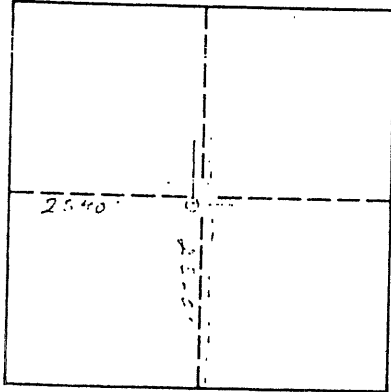

Please Note this is Restake on this Location as request by Dan REINEKE

MINIMUM STAKING CHARGE: \$85.00  
 (INCLUDES GROUND ELEVATION)  
 EXTRA TIME & MILEAGE: \_\_\_\_\_  
 ELEVATION CHARGE: \_\_\_\_\_  
 TOTAL: \$85.00

*Vernon C Becker*  
L-S SURVEYOR

Laughlin-Simmons & Co. of Kansas, Inc. is not liable in case of errors and/or omissions.

# KANSAS

CORPORATION COMMISSION

Kathleen Sebelius, Governor    Brian J. Moline, Chair    Robert E. Krehbiel, Commissioner    Michael C. Moffet, Commissioner

## NOTICE OF RECEIPT OF WELL PLUGGING APPLICATION (CP-1)

June 16, 2006

XTO Energy Inc.  
210 Park Avenue - Suite 2350  
Oklahoma City, OK 73102

Re: MASONIC HOME #3-2  
API 15-093-20352-00-00  
NENENESW 36-25S-36W, 2520 FSL 2540 FWL  
KEARNY COUNTY, KANSAS

Dear Operator:

This letter is to notify you that the Conservation Division is in receipt of your plugging proposal, form CP-1, for the above-captioned well.


Your CP-1 has been reviewed by the Conservation Division central office for completeness and to verify license numbers. The plugging proposal will now be forwarded to the district office listed below for review of your proposed method of plugging.

**Please contact the district office for approval of your proposed plugging method at least five (5) days before plugging the well, pursuant to K.A.R. 82-3-113 (b). If a workover pit will be used during the plugging of the well it must be permitted. A CDP-1 form must be filed and approved prior to the use of the pit.**

The Conservation Division's review of form CP-1, either in the central or district office, does not include an inquiry into well ownership or the filing operator's legal right to plug the well.

**This notice in no way constitutes authorization to plug the above-captioned well by persons not having legal rights of ownership or interest in the well. This notice is void after ninety (90) days from the above date.**

Sincerely

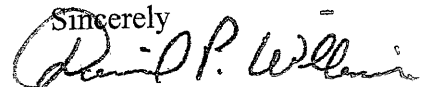

David P. Williams  
Production Supervisor

District: #1  
210 E Frontview, Suite A  
Dodge City, KS 67801  
(620) 225-8888