

CARD MUST BE TYPED

State of Kansas
NOTICE OF INTENTION TO DRILL
(see rules on reverse side)

CARD MUST BE SIGNED

Starting Date: 7 1 85
..... day year

API Number 15- 059-23,955-0000

OPERATOR: License # 7730

SE SE NE
(location) Sec 1 Twp 17 S, Rge 20 East West

Name
Address Box 75
City/State/Zip Wellsville, KS 66092
Contact Person Gary Vickers
Phone (913)883-2171

2845 Ft North from Southeast Corner of Section
495 Ft West from Southeast Corner of Section
(Note: Locate well on Section Plat on reverse side)

CONTRACTOR: License # 5666
Name Finch's Drilling
City/State Rt. 2, Ottawa, Ks. 66067

Nearest lease or unit boundary line 495 feet.
County Franklin
Lease Name David Anderson, Well# 4

Well Drilled For: Well Class: Type Equipment:
 Oil Swd Field Mud Rotary
 Gas Inj Pool Ext. Air Rotary
 OWWO Expl Wildcat Cable

Domestic well within 330 feet: yes no
Municipal well within one mile: yes no

If OWWO: old well info as follows:
Operator
Well Name
Comp Date Old Total Depth
Projected Total Depth 750 feet
Projected Formation at TD Squirrel
Expected Producing Formations

Depth to Bottom of fresh water 100 feet
Lowest usable water formation
Depth to Bottom of usable water 200 feet
Surface pipe by Alternate: 1 2
Surface pipe to be set 21 feet
Conductor pipe if any required feet
Ground surface elevation feet MSL
This Authorization Expires 12-28-85
Approved By 6-28-85 PC

I certify that we will comply with K.S.A. 55-101, et seq., plus eventually plugging hole to K.C.C. specifications.

Date 6/28/85 Signature of Operator or Agent Raquel Lobles Title As. agent

PC
RCH FOR RCH

Must be filed with the K.C.C. five (5) days prior to commencing well
 This card void if drilling not started within six (6) months of date received by K.C.C.


RECEIVED
 STATE CORPORATION COMMISSION
 AT...

6-28-85

JUN 28 1985

Important procedures to follow:

A Regular Section of the CONSERVATION DIVISION
 1 Mile = 5,280 Ft. Wichita, Kansas

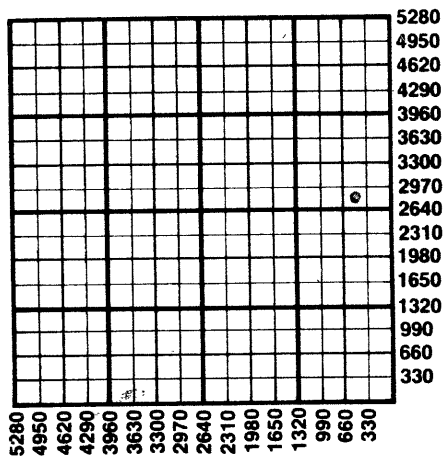

1. Notify District office before setting surface casing.
2. Set surface casing by circulating cement to the top.
3. File completion forms ACO-1 with K.C.C. within 90 days of well completion, following instructions on ACO-1, side 1, and including copies of wireline logs.
4. Notify District office 48 hours prior to old well workover or re-entry.
5. Prior to plugging, prepare a plugging plan, then obtain agreement from the appropriate district office for an approved plugging plan.
6. Submit plugging report (CP-4) to K.C.C. after plugging is completed.
7. Obtain an approved injection docket number before disposing of salt water.
8. Notify K.C.C. within 10 days when injection commences or terminates.
9. If an alternate 2 completion, cement in the production pipe from below any usable water to surface within 120 days of spud date.

State Corporation Commission of Kansas
 Conservation Division
 200 Colorado Derby Building
 Wichita, Kansas 67202
 (316) 263-3238