

CARD MUST BE TYPED

State of Kansas  
**NOTICE OF INTENTION TO DRILL**  
(see rules on reverse side)

CARD MUST BE SIGNED

Starting Date: April 1, 1985  
month day year

API Number 15- 059-23,874-0000

OPERATOR: License # 5185

W  $\frac{1}{2}$ , SE  $\frac{1}{4}$  ... Sec .15. Twp .17. S, Rge .19.  East  West  
(location)

Name Elmer C. Sieg Dr.

Address 923 N. Cherry

City/State/Zip Ottawa, Ks. 66067

Contact Person Elmer C. Sieg

Phone 913-242-1840

750 Ft North from Southeast Corner of Section  
2070 Ft West from Southeast Corner of Section  
(Note: Locate well on Section Plat on reverse side)

CONTRACTOR: License # 6913

Nearest lease or unit boundary line 750 feet.  
County Franklin

Name Casady Drilling Co.

City/State 1632 Chestnut, Ottawa, Ks.

Lease Name Antone Well# 2

Domestic well within 330 feet:  yes  no

Municipal well within one mile:  yes  no

Well Drilled For: Well Class: Type Equipment:

- |   |                               |   |  |
|---|-------------------------------|---|--|
| <input checked="" type="checkbox"/> Oil | <input type="checkbox"/> Swd  | <input checked="" type="checkbox"/> Infield | <input type="checkbox"/> Mud Rotary            |
| <input type="checkbox"/> Gas            | <input type="checkbox"/> Inj  | <input type="checkbox"/> Pool Ext.          | <input checked="" type="checkbox"/> Air Rotary |
| <input type="checkbox"/> OWWO           | <input type="checkbox"/> Expl | <input type="checkbox"/> Wildcat            | <input type="checkbox"/> Cable                 |

Depth to Bottom of fresh water 150 feet

Lowest usable water formation Ireland S.S.

Depth to Bottom of usable water 200 feet

Surface pipe by Alternate: 1  2

Surface pipe to be set 20 40 Min. feet

Conductor pipe if any required \_\_\_\_\_ feet

Ground surface elevation \_\_\_\_\_ feet MSL

This Authorization Expires 10-1-85

Approved By 4-1-85 *[Signature]*

If OWWO: old well info as follows:

Operator \_\_\_\_\_

Well Name \_\_\_\_\_

Comp Date \_\_\_\_\_ Old Total Depth \_\_\_\_\_

Projected Total Depth 1100 feet

Projected Formation at TD Bartlesville

Expected Producing Formations Bartlesville

I certify that we will comply with K.S.A. 55-101, et seq., plus eventually plugging hole to K.C.C. specifications.

Date 3-27-85 Signature of Operator or Agent Elmer C. Sieg Title Owner-Operator


*mhc MOHE 4-1-85*

Must be filed with the K.C.C. five (5) days prior to commencing well  
This card void if drilling not started within six (6) months of date received by K.C.C.

4-1-85

APC-1 1985

A Regular Section of Land  
1 Mile = 5,280 Ft.

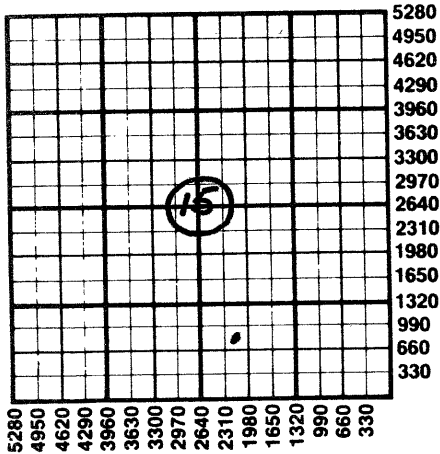

**Important procedures to follow :**

1. Notify District office before setting surface casing.
2. Set surface casing by circulating cement to the top.
3. File completion forms ACO-1 with K.C.C. within 90 days of well completion, following instructions on ACO-1, side 1, and including copies of wireline logs.
4. Notify District office 48 hours prior to old well workover or re-entry.
5. Prior to plugging, prepare a plugging plan, then obtain agreement from the appropriate district office for an approved plugging plan.
6. Submit plugging report (CP-4) to K.C.C. after plugging is completed.
7. Obtain an approved injection docket number before disposing of salt water.
8. Notify K.C.C. within 10 days when injection commences or terminates.
9. If an alternate 2 completion, cement in the production pipe from below any usable water to surface within 120 days of spud date.

State Corporation Commission of Kansas  
Conservation Division  
200 Colorado Derby Building  
Wichita, Kansas 67202  
(316) 263-3238