

Notice: Fill out COMPLETELY and return to Conservation Division at the address below within 60 days from plugging date.

KANSAS CORPORATION COMMISSION
OIL & GAS CONSERVATION DIVISION
WELL PLUGGING RECORD
K.A.R. 82-3-117

Form CP-4
December 2003
Type or Print on this Form
Form must be Signed
All blanks must be Filled

Lease Operator: Casebeer, Inc.
Address: 909 North High Drive, McPherson KS 67460
Phone: (620) 242-7766 Operator License #: 31934
Type of Well: Oil & SWD Docket #: unknown
(Oil, Gas D&A, SWD, ENHR, Water Supply Well, Cathodic, Other) (If SWD or ENHR)
The plugging proposal was approved on: 6/15/06 KCC 6/27/06 (Date)
by: Greg Eves per CP 2/3
(KCC District Agent's Name)
Is ACO-1 filed? Yes No If not, is well log attached? Yes No
Producing Formation(s): List All (if needed attach another sheet)
Mississippi Depth to Top: 3022 Bottom: 3025 T.D. 3075
Depth to Top: _____ Bottom: _____ T.D. _____
Depth to Top: _____ Bottom: _____ T.D. _____

API Number: 15-11302021-00-00
Lease Name: Enberg KCC PICT
Well Number: 2 6/27/06 Per CP 2/3
Spot Location (QQQQ): _____ - SW - NW - NW4 Fig 5
990 4323 Feet from North / South Section Line Co PSD
330 5154 Feet from East / West Section Line
Sec. 18 Twp. 19 S. R. 2 East West
County: McPherson
Date Well Completed: 12/12/1958
Plugging Commenced: 6/19/06
Plugging Completed: 6/19/06

Show depth and thickness of all water, oil and gas formations.

Oil, Gas or Water Records		Casing Record (Surface Conductor & Production)				
Formation	Content	From	To	Size	Put In	Pulled Out
clay & sand	clay & sand	Surface	95	10 3/4"	203	none
Mississippi	lime & chert	2983	3072	7"	3075	none

Describe in detail the manner in which the well is plugged, indicating where the mud fluid was placed and the method or methods used in introducing it into the hole. If cement or other plugs were used, state the character of same depth placed from (bottom), to (top) for each plug set.

tried for two days to pull tubing and clean hole, got pieces of decayed tubing and reached depth of 180'- got hold of tubing and ran rods and bit through tubing and reached depth of 560'- pour 80 gallons of sand down tubing- shot tubing off at 495'- perforated 7" casing at 475 to 476 feet - Copeland cementing pumped cement to fill 7" casing - would not circulate to surface - pumped cement between 7" and 10 3/4" pipe used total of 225+ sacks cement - plugging okayed by Virgil Clothier


Name of Plugging Contractor: Scott's Well Service License #: 6819
Address: P.O. Box 130, Roxbury KS 67476

Name of Party Responsible for Plugging Fees: Casebeer, Inc. (Charles Casebeer)
State of Kansas County, McPherson, ss.

Mark S. Casebeer (Employee of Operator) or (Operator) on above-described well, being first duly sworn on oath, says: That I have knowledge of the facts statements, and matters herein contained, and the log of the above-described well is as filed, and the same are true and correct, so help me God.

(Signature) Mark Casebeer
(Address) 213 North Third, Lindsborg KS 67456

SUBSCRIBED and SWORN TO before me this 22 day of June, 2006
Jerry Lovett Sperling My Commission Expires: 5-6-10
Notary Public

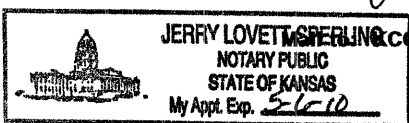

KCC - Conservation Division, 130 S. Market - Room 2078, Wichita, Kansas 67202

RECEIVED
JUN 26 2006
KCC WICHITA

WELL LOG BUREAU—KANSAS GEOLOGICAL SOCIETY
508 East Murdock, Wichita, Kansas


COPY

Company- ZION OIL COMPANY
Farm- Enberg No. 2

SEC. 18 T. 19 R. 2W
SW NW NW

Total Depth. 3145'
Comm. 9-30-58 Comp. 10-9-58
Shot or Treated.
Contractor. Greenland Drilling Company,
Issued. 12-27-58

County McPherson
KANSAS

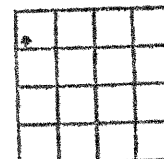

Elevation. 1548' R.B. (Est.)

CASING:
10 3/4" @ 203'
2" @ 3075'

Production. 20 BOPD/Mississippi
S.W.D.W./Lower Mississippi

Figures Indicate Bottom of Formations.

Clay & sand	95
shale	130
shale & lime	203
shale & shells	390
lime & shale	520
shale, lime, & red bed	548
lime & shale	855
sandy lime & shale	1015
shale w/lime streaks	1384
shale & lime	1837
lime & shale	2095
shale & lime	2253
lime & shale	2290
Brown lime & shale	2347
Lansing lime & shale	2385
Lansing lime	2459
lime & shale	2663
shale & lime	2983
Mississippi	3072
Mississippi lime & chert	3106 RTD
Mississippi lime & Chert	3145
Total Depth.	

K. G. S. LIBRARY

Well north 940

TOPS:

LANSING	2340
Mississippi	2983

RECEIVED
JUN 26 2006
KCC WICHITA

15-113-02621

ZION OIL & GAS

#2 ENBERG

18-19-2W
SW NW NW

Contr. GREENLAND DRILG CO

McPHERSON County

E 1519RB Comm

Comp. 12-12-58

IP 20 BOPD/MLSS
SWD/LOWER MLSS

Tops	Depth	Datum
MISS	2985	-1436
TD	3145	-1596

Casing 10-29-97
10" 203 This well TA - may be
7" 3075 tested upon SWD
WTR: PB 3075: PERF 3060-63:
ACID 250: WTR: PB 3057: PERF
3003-05: WTR: ACID 250: WTR:
PERF 3022-25: WTR & SO: ACID
750: 1/2 BO & 5 BWPB: CO 3145:
PKR 3035: DUAL COMPLETION

INDEPENDENT OIL & GAS SERVICE
WICHITA, KANSAS

RECEIVED
JUN 26 2006
KCC WICHITA