

KANSAS CORPORATION COMMISSION  
OIL & GAS CONSERVATION DIVISION

RECEIVED

MAY 31 2006

Form CP-1  
September 2003

WELL PLUGGING APPLICATION

KCC WICHITA

This Form must be Typed  
Form must be Signed  
All blanks must be Filled

Please TYPE Form and File ONE Copy

API # 15 - 113-02076 - 00-00 (Identifier Number of this well). This must be listed for wells drilled since 1967; if no API # was issued, indicate original spud or completion date 7/12/56

Well Operator: E & E OIL KCC License #: 31448  
(Owner / Company Name) (Operator's)

Address: P.O. BOX 451 City: CANTON

State: KANSAS Zip Code: 67428 Contact Phone: ( 620 ) 628 - 4858

Lease: STATE F-1 Well #: 102 Sec. 21 Twp. 18 S. R. 01  East  West

NE - SE - SE/4 Spot Location / QQQQ County: MCPHERSON

1180 Feet (in exact footage) From  North /  South (from nearest outside section corner) Line of Section (Not Lease Line)

330 Feet (in exact footage) From  East /  West (from nearest outside section corner) Line of Section (Not Lease Line)

Check One:  Oil Well  Gas Well  D&A  Cathodic  Water Supply Well  
 SWD Docket # \_\_\_\_\_  ENHR Docket # \_\_\_\_\_  Other: \_\_\_\_\_

Conductor Casing Size: \_\_\_\_\_ Set at: \_\_\_\_\_ Cemented with: \_\_\_\_\_ Sacks

Surface Casing Size: 8-5/8" Set at: 120' Cemented with: 100 Sacks

Production Casing Size: 4-1/2' Set at: 2786' Cemented with: 75 Sacks

List (ALL) Perforations and Bridgeplug Sets: PERFS 2750'-2785'

Elevation: 1423 ( G.L. /  K.B.) T.D.: \_\_\_\_\_ P.B.T.D.: \_\_\_\_\_ Anhydrite Depth: \_\_\_\_\_  
(Stone Corral Formation)

Condition of Well:  Good  Poor  Casing Leak  Junk in Hole

Proposed Method of Plugging (attach a separate page if additional space is needed): ACCORDING TO THE RULES AND REGULATIONS OF THE KANSAS CORPORATION COMMISSION

Is Well Log attached to this application as required?  Yes  No Is ACO-1 filed?  Yes  No

If not explain why? NONE IN FILES WE RECEIVED FROM PREVIOUS OPERATOR

Plugging of this Well will be done in accordance with K.S.A. 55-101 et. seq. and the Rules and Regulations of the State Corporation Commission.

List Name of Company Representative authorized to be in charge of plugging operations: LAWRENCE D EVERHART

Phone: ( 620 ) 654 - 8140

Address: P.O. BOX 451 City / State: CANTON, KANSAS 67428

Plugging Contractor: MIKE'S TESTING & SALVAGE, INC KCC License #: 31529

Address: P.O. BOX 467, CHASE, KANSAS 67524 Phone: ( 620 ) 938 - 2943  
(Company Name) (Contractor's)

Proposed Date and Hour of Plugging (if known?): AS THEIR SCHEDULE WORKS

Payment of the Plugging Fee (K.A.R. 82-3-118) will be guaranteed by Operator or Agent  
Date: 5/25/06 Authorized Operator / Agent: Lawrence D. Everhart  
(Signature)

Mail to: KCC - Conservation Division, 130 S. Market - Room 2078, Wichita, Kansas 67202

OFFICE OF COUNTY ENGINEER

McPherson, Kansas

To: GLICKMAN OIL Co.  
702 So. ST. FRANCIS  
WICHITA, KANSAS

Date 6-27-1956

Well No. 2

Lease No. State "F"

Att:

County McPHERSON


Gentleman:

Confirming your request by DON MELLAND BY TELEPHONE

RECEIVED  
MAY 31 2006  
KCC WICHITA

we wish to advise that the above location was staked 6-27, 19 56

Section 21  
Twp. 18  
Range 1W

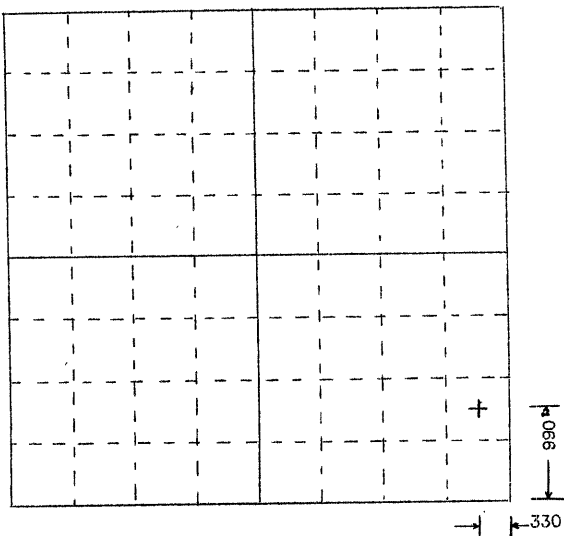

I, FRANCIS D. WAGNER, COUNTY ENGINEER, do hereby certify that I have ~~placed~~ caused to be placed location stake for the above named well at the following described location: NE-SE-SE- SECTION 21-18-1W

as shown on the above named PLAT.

JUNE 27, 1956  
Date

*Francis D. Wagner*  
Signature FRANCIS D. WAGNER

LAUGHLIN - SIMMONS & CO  
WELL ELEVATIONS

\_\_\_\_\_  
DATE

Glickman Oil Co.  
P. O. Box 3108  
Wichita, Kansas

Description:		Elevation
Glickman Oil Drlg	State "F" 2 NE SE SE 21-18S-1W (1180'FSL)	1421 1418

KANSAS

CORPORATION COMMISSION

Kathleen Sebelius, Governor    Brian J. Moline, Chair    Robert E. Krehbiel, Commissioner    Michael C. Moffet, Commissioner

**NOTICE OF RECEIPT OF WELL PLUGGING APPLICATION (CP-1)**

Everhart, Lawrence D. dba E & E Oil  
PO Box 451  
Canton, KS 67428

June 23, 2006

Re: STATE F-2 #F-2  
API 15-113-02076-00-00  
NESESE 21-18S-1W, 1180 FSL 4950 FWL  
MCPHERSON COUNTY, KANSAS

Dear Operator:

This letter is to notify you that the Conservation Division is in receipt of your plugging proposal, form CP-1, for the above-captioned well.

Your CP-1 has been reviewed by the Conservation Division central office for completeness and to verify license numbers. The plugging proposal will now be forwarded to the district office listed below for review of your proposed method of plugging.

**Please contact the district office for approval of your proposed plugging method at least five (5) days before plugging the well, pursuant to K.A.R. 82-3-113 (b). If a workover pit will be used during the plugging of the well it must be permitted. A CDP-1 form must be filed and approved prior to the use of the pit.**

The Conservation Division's review of form CP-1, either in the central or district office, does not include an inquiry into well ownership or the filing operator's legal right to plug the well.

**This notice in no way constitutes authorization to plug the above-captioned well by persons not having legal rights of ownership or interest in the well. This notice is void after ninety (90) days from the above date.**

District: #2  
3450 N. Rock Road, Suite 601  
Wichita, KS 67226  
(316) 630-4000

Sincerely



David P. Williams  
Production Supervisor