

CARD MUST BE TYPED

State of Kansas NOTICE OF INTENTION TO DRILL

CARD MUST BE SIGNED

(see rules on reverse side)

Starting Date: 10/5/84
month day year

API Number 15- 059-23,735-0000

OPERATOR: License # 6795
Name Peck Oil Co., Inc.
Address 12828 W. 66th Terr.
City/State/Zip Shawnee, Ks. 66216
Contact Person R.C. Peck
Phone 913-268-6878

SW, SE, NE, Sec 31, Twp 17, S, Rge 21. East
(location) West

3280 Ft North from Southeast Corner of Section
910 Ft West from Southeast Corner of Section
(Note: Locate well on Section Plat on reverse side)

CONTRACTOR: License # 6795
Name Peck Oil Co., Inc.
City/State Shawnee, Ks

Nearest lease or unit boundary line 910 feet.
County Franklin
Lease Name Peck Well # 4A

Domestic well within 330 feet: yes no
Municipal well within one mile: yes no

Well Drilled For: Well Class: Type Equipment:
 Oil Swd Infield Mud Rotary
 Gas Inj Pool. Ext. Air Rotary
 OWWO Expl Wildcat Cable

Depth to Bottom of fresh water 30 feet

Lowest usable water formation

Depth to Bottom of usable water 200 feet

Surface pipe by Alternate: 1 2

Surface pipe to be set 20 feet

Conductor pipe if any required

Ground surface elevation 950 feet MSL

This Authorization Expires 3-26-85

Approved By R.C. Peck 9-16-84

If OWWO: old well info as follows:

Operator
Well Name
Comp Date Old Total Depth
Projected Total Depth 650 feet
Projected Formation at TD Squirrel
Expected Producing Formations Squirrel


I certify that we will comply with K.S.A. 55-101, et seq., plus eventually plugging hole to K.C.C. specifications.

Date 9/21/84 Signature of Operator or Agent R.C. Peck Title Pres.

Must be filed with the K.C.C. five (5) days prior to commencing well
 This card void if drilling not started within six (6) months of date received by K.C.C.

Important procedures to follow :

**A Regular Section of Land
 1 Mile = 5,280 Ft.**

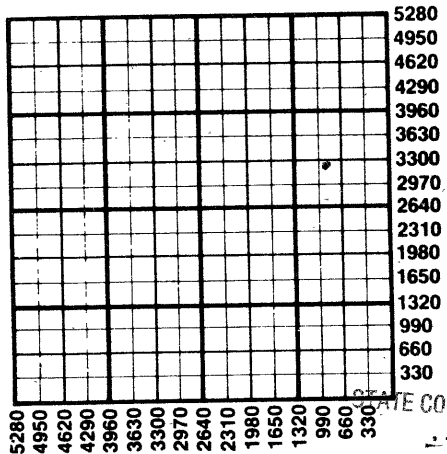

1. Notify District office before setting surface casing.
2. Set surface casing by circulating cement to the top.
3. File completion forms ACO-1 with K.C.C. within 90 days of well completion, following instructions on ACO-1, side 1, and including copies of wireline logs.
4. Notify District office 48 hours prior to old well workover or re-entry.
5. Prior to plugging, prepare a plugging plan, then obtain agreement from the appropriate district office for an approved plugging plan.
6. Submit plugging report (CP-4) to K.C.C. after plugging is completed.
7. Obtain an approved injection docket number before disposing of salt water.
8. Notify K.C.C. within 10 days when injection commences or terminates.
9. If an alternate 2 completion, cement in the production pipe from below any usable water to surface within 120 days of spud date.

RECEIVED
 STATE CORPORATION COMMISSION

State Corporation Commission of Kansas
 Conservation Division
 200 Colorado Derby Building
 Wichita, Kansas 67202
 (316) 263-3238

SEP 26 1991

CONSERVATION DIVISION
 Wichita, Kansas

926-84