CARD MUST BE TYPED

State of Kansas

NOTICE OF INTENTION TO DRILL

(see rules on reverse side)

CARD MUST BE SIGNED

√6

Expected Spud Date 03/17/88 (month day year)

API Number 15— 059-24,319-00-00

OPERATOR: License # 9098

Name M.C. Conathy Production Co., In

Address 509 Market #200

City/State/Zip Shreveport, La. 71101

Contact Person Terry Buck

Phone (318) 227-1498

CONTRACTOR: License # 5379

Name Kephart Drilling

City/State RR1 POB 68A Thayer Ks. 66776

NW NW NW Sec. 1 Twp. 18 S, Rg. 20 XX East ___ West

4950 Ft. from South Line of Section

4950 Ft. from East Line of Section

(Note: Locate well on Section Plat on reverse side)

Nearest lease or unit boundary line 330 feet

County Franklin

Lease Name Roseberry Well # 2

Ground surface elevation 1030 feet MSL

Domestic well within 330 feet: ___yes XX no

Municipal well within one mile: ___yes XX no

Depth to bottom of fresh water

Depth to bottom of usable water

Surface pipe by Alternate: 1 ___ 2 XX

Surface pipe planned to be set 21

Conductor pipe required

Projected Total Depth 1000 feet

Formation Squirrel-Cattleman

Well Drilled For:		Well Class:	Type Equipment:
___ Oil	___ Storage	XX Infield	XX Mud Rotary
XX Gas	___ Inj	___ Pool Ext.	___ Air Rotary
___ OWWO	___ Expl	___ Wildcat	___ Cable

If OWWO: old well info as follows:

Operator

Well Name

Comp Date Old Total Depth

I certify that well will comply with K.S.A. 55-101, et seq., plus eventually plugging hole to KCC specifications.

Date 03/17/88 Signature of Operator or Agent [signature] Title As Agent

For KCC Use:

Conductor Pipe Required ___ feet; Minimum Surface Pipe Required 20 feet per Alt. X (2)

This Authorization Expires 9-17-88 Approved By [initials] 3-17-88

EFFECTIVE DATE: 3-22-88

Must be filed with the K.C.C. five (5) days prior to commencing well
This card void if drilling not started within six (6) months of date received by K.C.C.

A Regular Section of Land
1 Mile = 5,280 Ft.

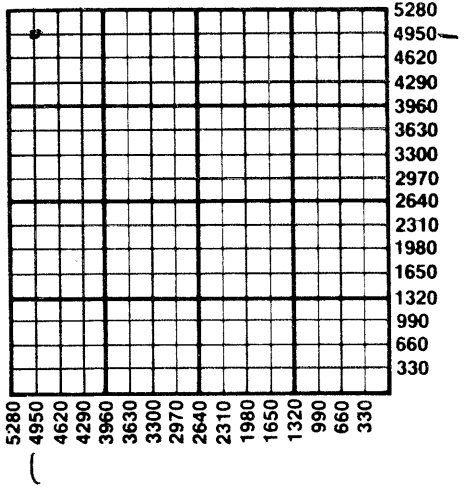

Important procedures to follow:

1. Notify District office before setting surface casing.
2. Set surface casing by circulating cement to the top.
3. File completion forms ACO-1 with K.C.C. within 120 days of well spud date, following instructions on ACO-1, side 1, and including copies of wireline logs.
4. Notify District office 48 hours prior to old well workover or re-entry.
5. Prior to filing Intent, prepare a proposed plugging plan in case well is D & A, then obtain approval of plan when calling district office prior to setting surface pipe.
6. Submit plugging report (CP-4) to K.C.C. after plugging is completed.
7. Obtain an approved injection docket number before disposing of salt water.
8. Notify K.C.C. within 10 days when injection commences or terminates.
9. If an alternate 2 completion, cement in the production pipe from below any usable water to surface within 120 days of spud date.

RECEIVED
STATE CORPORATION COMMISSION
MAR 17 1988
3-17-88
CONSERVATION DIVISION
Wichita, Kansas

State Corporation Commission of Kansas
Conservation Division
200 Colorado Derby Building
Wichita, Kansas 67202-1212
(316) 263-3238