

CARD MUST BE TYPED

State of Kansas
NOTICE OF INTENTION TO DRILL
(see rules on reverse side)

CARD MUST BE SIGNED

Starting Date: Oct. 12, 1984
month day year

API Number 15-

059-23,746-0000

OPERATOR: License # 5692
Name Hughes Drilling Company
Address 122 North Main
City/State/Zip Wellsville, Kansas 66092
Contact Person Roger A. Hughes
Phone 1-913-883-2235

NW NW SE Sec 3 Twp 18 S, Rge 20
(location)
1995 Ft North from Southeast Corner of Section
2470 Ft West from Southeast Corner of Section
(Note: Locate well on Section Plat on reverse side)

CONTRACTOR: License # 5682
Name Hughes Drilling Company
City/State Wellsville, Kansas

Nearest lease or unit boundary line 170 feet.
County Franklin
Lease Name Forrer Well# 3
Domestic well within 330 feet: ☐ yes ☒ no
Municipal well within one mile: ☐ yes ☒ no

Well Drilled For:	Well Class:	Type Equipment:
☒ Oil ☐ Swd ☐ Infield		☒ Mud Rotary
☐ Gas ☐ Inj ☒ Pool Ext.		☐ Air Rotary
☐ OWWO ☐ Expl ☐ Wildcat		☐ Cable

If OWWO: old well info as follows:

Operator
Well Name
Comp Date Old Total Depth
Projected Total Depth 800 feet
Projected Formation at TD #2 Squirrel
Expected Producing Formations #2 Squirrel

Depth to Bottom of fresh water feet
Lowest usable water formation Unknown
Depth to Bottom of usable water 200 feet
Surface pipe by Alternate: 1 ☐ 2 ☒
Surface pipe to be set 20 feet
Conductor pipe if any required feet
Ground surface elevation feet MSL
This Authorization Expires 4-9-85
Approved By 10-9-84

I certify that we will comply with K.S.A. 55-101, et seq., plus eventually plugging hole to K.C.C. specifications.

Date 10-4-84 Signature of Operator or Agent

Beatrice E. Hughes Secretary
KOM-KOHE 10-9-84

Must be filed with the K.C.C. five (5) days prior to commencing well
This card void if drilling not started within six (6) months of date received by K.C.C.

RECEIVED
STATE CORPORATION COMMISSION


OCT 09 1984

Important procedures to follow:

CONSERVATION DIVISION
Wichita, Kansas

10-9-84

A Regular Section of Land
1 Mile = 5,280 Ft.

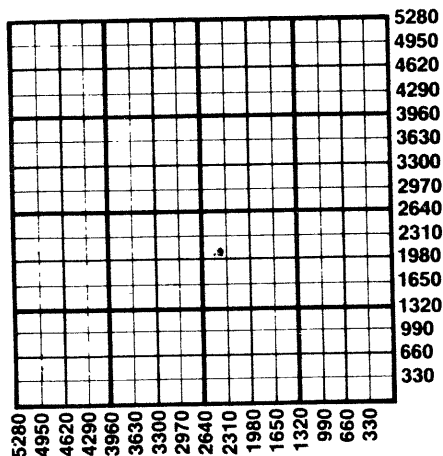

1. Notify District office before setting surface casing.
2. Set surface casing by circulating cement to the top.
3. File completion forms ACO-1 with K.C.C. within 90 days of well completion, following instructions on ACO-1, side 1, and including copies of wireline logs.
4. Notify District office 48 hours prior to old well workover or re-entry.
5. Prior to plugging, prepare a plugging plan, then obtain agreement from the appropriate district office for an approved plugging plan.
6. Submit plugging report (CP-4) to K.C.C. after plugging is completed.
7. Obtain an approved injection docket number before disposing of salt water.
8. Notify K.C.C. within 10 days when injection commences or terminates.
9. If an alternate 2 completion, cement in the production pipe from below any usable water to surface within 120 days of spud date.

1995' N from SE corner of Sec.
2470' W from SE corner of Sec,

State Corporation Commission of Kansas
Conservation Division
200 Colorado Derby Building
Wichita, Kansas 67202
(316) 263-3238