

CARD MUST BE TYPED

State of Kansas **NOTICE OF INTENTION TO DRILL** (see rules on reverse side)

CARD MUST BE SIGNED

Starting Date: ... Sept. ... 13 ... 1984 ...
 month day year

OPERATOR: License # ... 5682 ...
 Name .. Hughes Drilling Company
 Address 122 North Main
 City/State/Zip Wellsville, Kansas 66092 ..
 Contact Person Roger A. Hughes
 Phone 1-913-883-2235

CONTRACTOR: License # ... 5682 Rig 305
 Name ... Hughes Drilling Company
 City/State ... Wellsville, Kansas 66092

Well Drilled For:	Well Class:	Type Equipment:
☒ Oil	☐ Swd	☒ Mud Rotary
☐ Gas	☐ Inj	☐ Air Rotary
☐ OWWO	☐ Expl	☐ Cable
	☒ Infield	
	☐ Pool Ext.	
	☐ Wildcat	

If OWWO: old well info as follows:

Operator
 Well Name
 Comp Date Old Total Depth
 Projected Total Depth ... 800 ... feet
 Projected Formation at TD ... #2 Squirrel
 Expected Producing Formations ... #2 Squirrel

I certify that we will comply with K.S.A. 55-101, et seq., plus eventually plugging hole to K.C.C. specifications.

Date 9-6-84 Signature of Operator or Agent

API Number 15-

059-23, 715-00-00
 SW $\frac{1}{4}$ NE $\frac{1}{4}$... Sec .3. Twp 18. S, Rge 20. ☒ East ☐ West
 (location)

2860 Ft North from Southeast Corner of Section
 2420 Ft West from Southeast Corner of Section
 (Note: Locate well on Section Plat on reverse side)

Nearest lease or unit boundary line ... 220 ... feet.

County ... Franklin

Lease Name ... Nokes Well# ... 3

Domestic well within 330 feet : ☐ yes ☒ noMunicipal well within one mile : ☐ yes ☒ no

Depth to Bottom of fresh water feet

Lowest usable water formation ... Unknown ... feet

Depth to Bottom of usable water ... 200 ... feet

Surface pipe by Alternate : 1 ☐ 2 ☒

Surface pipe to be set ... 20 ... feet

Conductor pipe if any required feet

Ground surface elevation feet MSL

This Authorization Expires ... 3-10-85

Approved By ... 9-10-84

Date 9-6-84 Signature of Operator or Agent Beatrice E. Ziegler

Title


Secretary

MHC/KONE 9/10/84

Must be filed with the K.C.C. five (5) days prior to commencing well
This card void if drilling not started within six (6) months of date received by K.C.C.

Important procedures to follow:

**A Regular Section of Land
1 Mile = 5,280 Ft.**

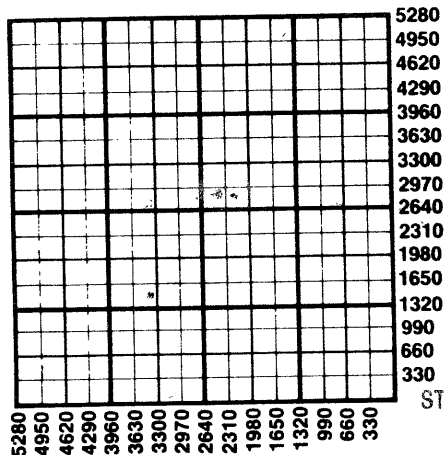

1. Notify District office before setting surface casing.
2. Set surface casing by circulating cement to the top.
3. File completion forms ACO-1 with K.C.C. within 90 days of well completion, following instructions on ACO-1, side 1, and including copies of wireline logs.
4. Notify District office 48 hours prior to old well workover or re-entry.
5. Prior to plugging, prepare a plugging plan, then obtain agreement from the appropriate district office for an approved plugging plan.
6. Submit plugging report (CP-4) to K.C.C. after plugging is completed.
7. Obtain an approved injection docket number before disposing of salt water.
8. Notify K.C.C. within 10 days when injection commences or terminates.
9. If an alternate 2 completion, cement in the production pipe from below any usable water to surface within 120 days of spud date.

RECEIVED
STATE CORPORATION COMMISSION

State Corporation Commission of Kansas
Conservation Division
200 Colorado Derby Building
Wichita, Kansas 67202
(316) 263-3238

9-10-84
SEP 10 1984
CONSERVATION DIVISION
Wichita, Kansas