

CARD MUST BE TYPED

State of Kansas

CARD MUST BE SIGNED

NOTICE OF INTENTION TO DRILL

(see rules on reverse side)

Expected Spud Date..... 05/04/88
month day year

OPERATOR: License #..... 9873
Name..... PAINTER OIL COMPANY
Address..... P.O. BOX 141B, RT. 2
City/State/Zip..... WELLSVILLE 66092
Contact Person..... MAX PAINTER
Phone..... (901) 685-7121

CONTRACTOR: License # 2417
Name..... Simpson Drilling
City/State..... Osawatomie, Kansas 66064

Well Drilled For: Well Class: Type Equipment:
 Oil Storage Infield Mud Rotary
 Gas Inj Pool Ext. Air Rotary
 OWWO Expl Wildcat Cable

If OWWO: old well info as follows:

Operator.....
Well Name.....
Comp Date..... Old Total Depth.....

I certify that well will comply with K.S.A. 55-101, et seq., plus eventually plugging hole to KCC specifications.

Date 05/04/88..... Signature of Operator or Agent *Deq Engeman* Title As Agent

For KCC Use:

Conductor Pipe Required..... feet; Minimum Surface Pipe Required..... 20 feet per Alt. **Y (2)**
This Authorization Expires 11-4-88..... Approved By *2011 5-4-88*

EFFECTIVE DATE: 5-9-88

API Number 15- 059-24.336-00-00
NW NE NW Sec 3 Twp 16 S, Rg 20
4950 Ft. from South Line of Section
3700 Ft. from East Line of Section

(Note: Locate well on Section Plat on reverse side)

Nearest lease or unit boundary line..... 165 feet
County..... Franklin
Lease Name..... Lester Scott Well #..... 8
Ground surface elevation..... feet MSL
Domestic well within 330 feet: yes no
Municipal well within one mile: yes no
Depth to bottom of fresh water.....
Depth to bottom of usable water..... 200
Surface pipe by Alternate: 1 2
Surface pipe planned to be set..... 20
Conductor pipe required.....
Projected Total Depth..... 950 feet
Formation..... Bartlesville


KCC

Must be filed with the K.C.C. five (5) days prior to commencing well
 This card void if drilling not started within six (6) months of date received by K.C.C.

Important procedures to follow:

1. Notify District office before setting surface casing.
2. Set surface casing by circulating cement to the top.
3. File completion forms ACO-1 with K.C.C. within 120 days of well spud date, following instructions on ACO-1, side 1, and including copies of wireline logs.
4. Notify District office 48 hours prior to old well workover or re-entry.
5. Prior to filing Intent, prepare a proposed plugging plan in case well is D & A, then obtain approval of plan when calling district office prior to setting surface pipe.
6. Submit plugging report (CP-4) to K.C.C. after plugging is completed.
7. Obtain an approved injection docket number before disposing of salt water.
8. Notify K.C.C. within 10 days when injection commences or terminates.

**A Regular Section of Land
 1 Mile = 5,280 Ft.**

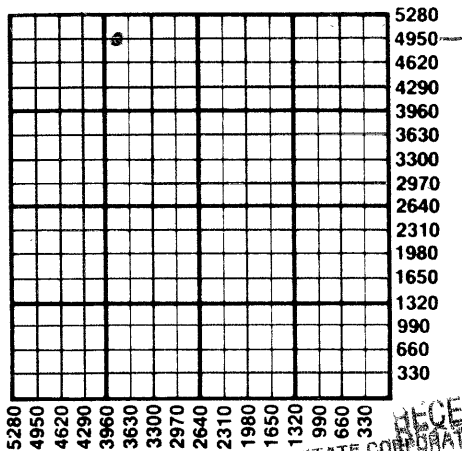

RECEIVED
 STATE CORPORATION COMMISSION

MAY 04 1988
 CONSERVATION DIVISION
 Wichita, Kansas

54-88

State Corporation Commission of Kansas
 Conservation Division
 200 Colorado Derby Building
 Wichita, Kansas 67202-1212
 (316) 263-3238

If an alternate 2 completion, cement in the production pipe from below any usable water to surface within 120 days of spud date.