

CARD MUST BE TYPED

State of Kansas  
**NOTICE OF INTENTION TO DRILL**  
(see rules on reverse side)

CARD MUST BE SIGNED

Starting Date: ..... 8 ..... 30 ..... 84 .....  
month day year

API Number 15- 003-22, 488-00-00

OPERATOR: License # 8210

SW SW NE Sec 8 Twp 21 S, Rge 18  East  
(location)  West

Name Edward E. Birk

Address R.R. #3

City/State/Zip Burlington, Kansas 66839

Contact Person Edward E. Birk

Phone 316-364-2745

3205 ..... Ft North from Southeast Corner of Section

2485 ..... Ft West from Southeast Corner of Section

(Note: Locate well on Section Plat on reverse side)

CONTRACTOR: License # 5367

Nearest lease or unit boundary line ..... 2075FWL ..... feet.

Name Double I Drilling

County Anderson

City/State Box 284 Yates Center, Kansas 66783

Lease Name Croucher Well# 1

Well Drilled For: Well Class: Type Equipment:

Oil  Swd  Infield  Mud Rotary

Gas  Inj  Pool Ext.  Air Rotary

OWWO  Expl  Wildcat  Cable

Domestic well within 330 feet:  yes  no

Municipal well within one mile:  yes  no

If OWWO: old well info as follows:

Operator .....

Well Name .....

Comp Date ..... Old Total Depth .....

Projected Total Depth ..... 1500 ..... feet

Projected Formation at TD Mississippian

Expected Producing Formations ..... U. Unknwn

Depth to Bottom of fresh water 20 ..... feet

Lowest usable water formation Sandstone & Gravel .....

Depth to Bottom of usable water 225 ..... feet

Surface pipe by Alternate: 1  2

Surface pipe to be set ..... 40 ..... feet

Conductor pipe if any required .. none ..... feet

Ground surface elevation ..... unkown ..... feet MSL

This Authorization Expires ..... 2-21-85

Approved By ..... E. Birk

I certify that we will comply with K.S.A. 55-101, et seq., plus eventually plugging hole to K.C.C. specifications.


Date 8-25-84 Signature of Operator or Agent Edward E. Birk Title Operator

mhc/hone 8/21/84

Must be filed with the K.C.C. five (5) days prior to commencing well  
This card void if drilling not started within six (6) months of date received by K.C.C.

**Important procedures to follow :**

**A Regular Section of Land  
1 Mile = 5,280 Ft.**

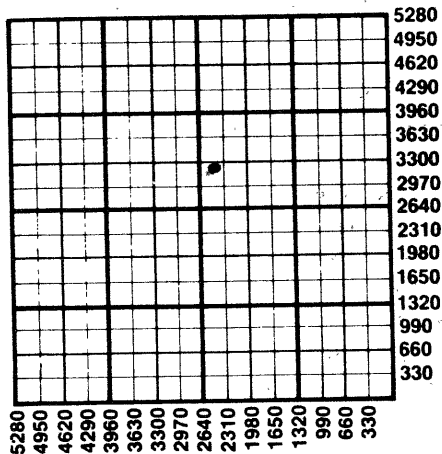

8-21-84

1. Notify District office before setting surface casing.
2. Set surface casing by circulating cement to the top.
3. File completion forms ACO-1 with K.C.C. within 90 days of well completion, following instructions on ACO-1, side 1, and including copies of wireline logs.
4. Notify District office 48 hours prior to old well workover or re-entry.
5. Prior to plugging, prepare a plugging plan, then obtain agreement from the appropriate district office for an approved plugging plan.
6. Submit plugging report (CP-4) to K.C.C. after plugging is completed.
7. Obtain an approved injection docket number before disposing of salt water.
8. Notify K.C.C. within 10 days when injection commences or terminates.
9. If an alternate 2 completion, cement in the production pipe from below any usable water to surface within 120 days of spud date.

CONSERVATION DIVISION  
Wichita, Kansas

AUG 21 1984

RECEIVED  
STATE CORPORATION COMMISSION

State Corporation Commission of Kansas  
Conservation Division  
200 Colorado Derby Building  
Wichita, Kansas 67202  
(316) 263-3238