


15-163-00814-00-00

Give All Information Completely
Make Required Affidavit
Mail or Deliver Report to:
Conservation Division
State Corporation Commission
212 North Market, Insurance Bldg.
Wichita, Kansas

WELL PLUGGING RECORD

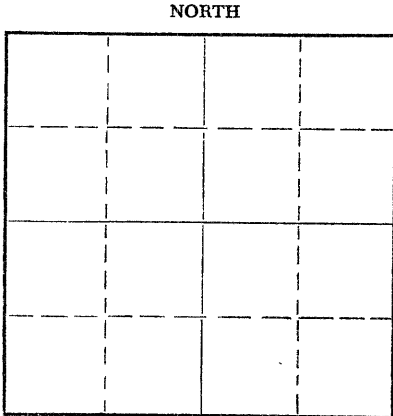

Locate well correctly on above Section Plat

Rooks County. Sec. 28 Twp. 8 Rge. 16W (E) (W)
Location as "NE/CNW/SW" or footage from lines NW SW SW
Lease Owner B. H. Hilburn
Lease Name Gager Well No. 1
Office Address 1514 Mercantile Security Bldg.
Character of Well (completed as Oil, Gas or Dry Hole) Dry Hole
Date well completed 5/21/ 19 61
Application for plugging filed 5/21/ 19 61
Application for plugging approved 5/21/ 19 61
Plugging commenced 5/21/ 19 61
Plugging completed 5/21/ 19 61
Reason for abandonment of well or producing formation No commercial quantities of oil or gas encountered
If a producing well is abandoned, date of last production 19
Was permission obtained from the Conservation Division or its agents before plugging was commenced? yes

Name of Conservation Agent who supervised plugging of this well Eldon Petty, Hays, Kansas
Producing formation None Depth to top _____ Bottom _____ Total Depth of Well _____ Feet
Show depth and thickness of all water, oil and gas formations.

OIL, GAS OR WATER RECORDS

CASING RECORD

FORMATION	CONTENT	FROM	TO	SIZE	PUT IN	PULLED OUT
Surface Casing		Surface	170'	8-5/8"	170'	None

Describe in detail the manner in which the well was plugged, indicating where the mud fluid was placed and the method or methods used in introducing it into the hole. If cement or other plugs were used, state the character of same and depth placed, from _____ feet to _____ feet for each plug set.

Drilling mud was introduced into the hole from a depth of 550' to 3340'. A wooden plug was set and cemented at 550' with 20 sacks of cement. Drilling mud was again introduced into the hole from a depth of 180' to 550', a plug set and cemented at 180' with 15 sacks of cement. Drilling mud was again introduced into the hole from a depth 40 feet to 180'; a flag set and cemented from surface to a depth of 40 feet. Surface casing was cut off below ground level and the location abandoned.

RECEIVED
STATE CORPORATION COMMISSION

JUN 1 1961

Name of Plugging Contractor Tomlinson-Kathol, Inc.
Address 414 Union Center, Wichita, Kansas

CONSERVATION DIVISION
Wichita, Kansas

0-1-61

STATE OF Kansas COUNTY OF Sedgwick, ss.
Richard C. Davis (employee of owner) or (owner or operator) of the above-described

well, being first duly sworn on oath, says: That I have knowledge of the facts, statements, and matters herein contained and the log of the above-described well as filed and that the same are true and correct. So help me God

(Signature) Richard C. Davis
414 Union Center, Wichita, Kansas (Address)

SUBSCRIBED AND SWORN to before me this 25th day of May, 19 61

My commission expires 1/19/65

Notary Public.



15-163-00814-00-00

DRILLERS LOG
B. H. HILBURN # 1 GAGER
NW SW SW, SEC. 28-8S-16W
ROOKS COUNTY, KANSAS

Contractor - Tomlinson-Kathol, Inc.

Commenced: 5/12/61
Completed: 5/21/61
Elevation 1959 KB

<u>From</u>	<u>To</u>	<u>Description</u>	<u>Remarks</u>
0	75	Post Rock	
75	187	Sand & Shale	170' 8-5/8" Surface casing with 150 sacks cement
187	470	Shale	
470	486	Sand	
486	713	Shale	
713	718	Sand, Stone	
718	791	Shale	
791	985	Shale, Sand streaks	
985	1032	Anhydrite	
1032	2340	Shale	
2340	2566	Shale, Lime	
2566	2871	Shale	
2871	2883	Shale, Lime	
2883	3078	Lime	Topeka 2823
3078	3138	Shale & Lime	Heebner 3043
3138	3340	Lime	Toronto 3063
3340		Total Depth	Lansing 3084

RECEIVED
STATE CORPORATION COMMISSION

JUN 1 1961

CONSERVATION DIVISION
Wichita, Kansas

6-1-61

1959
1125

I certify to the best of my knowledge and belief, the above represents a true and accurate Driller's Log record of the captioned well.

Richard C. Davis, Geologist

State of Kansas)
County of Sedgwick)

Subscribed and sworn to before me this 25th day of May, 1961.

Esther Lamone, Notary Public

My Commission Expires: 1/19/65