


15-163-02704-00-00

WELL PLUGGING RECORD

Give All Information Completely
Make Required Affidavit
Mail or Deliver Report to:
Conservation Division
State Corporation Commission
800 Bitting Building
Wichita, Kansas

Rooks County, Sec. 28, Twp. 8, Rge. (E) 16 (W)
Location as "NE/CNW $\frac{1}{4}$ SW $\frac{1}{4}$ " or footage from lines 330 N 330W of Center
Lease Owner Cities Service Oil Co.
Lease Name Harrison "B" Well No. 2
Office Address Bartlesville, Oklahoma
Character of Well (completed as Oil, Gas or Dry Hole) Dry Hole
Date well completed 11-28 1949
Application for plugging filed 11-28 1949
Application for plugging approved 11-28 1949
Plugging commenced 11-28 1949
Plugging completed 11-28 1949
Reason for abandonment of well or producing formation

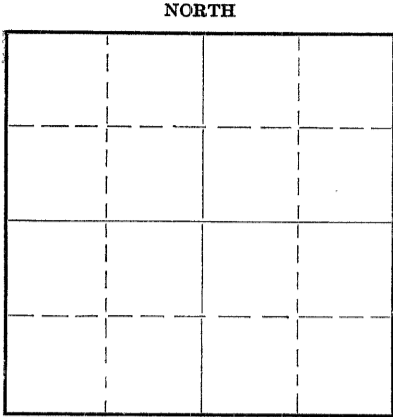

Locate well correctly on above Section Flat

If a producing well is abandoned, date of last production 19
Was permission obtained from the Conservation Division or its agents before plugging was commenced? yes

Name of Conservation Agent who supervised plugging of this well Mr. Eldon Petty
Producing formation Lansing-K.C. Depth to top 3070 Bottom Total Depth of Well 3445 Feet
Show depth and thickness of all water, oil and gas formations.

OIL, GAS OR WATER RECORDS

CASING RECORD

Formation	Content	From	To	Size	Put In	Pulled Out
Lansing-K.C.	Dry			8-5/8	301	none

Describe in detail the manner in which the well was plugged, indicating where the mud fluid was placed and the method or methods used in introducing it into the hole. If cement or other plugs were used, state the character of same and depth placed, from feet to feet for each plug set.

Filled with mud from total depth to 300 feet, set plug, dumped 15 sacks cement, mud to 30 feet, dumped 10 sacks cement, mud and dirt to surface.

12-13-49

(If additional description is necessary, use BACK of this sheet)

Correspondence regarding this well should be addressed to Mr. R. C. Cooper
Address Box 751, Great Bend, Kansas

STATE OF KANSAS, COUNTY OF BARTON, ss.

Mr. James Porter (employee of owner) or (owner or operator) of the above-described well, being first duly sworn on oath, says: That I have knowledge of the facts, statements, and matters herein contained and the log of the above-described well as filed and that the same are true and correct. So help me God.


(Signature)

Box 553, Russell, Kansas (Address)

SUBSCRIBED AND SWORN TO before me this 7th day of December, 1949

W. G. Smith
Notary Public.

My commission expires 3-17-1951

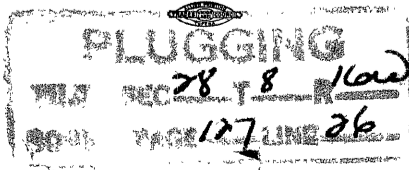

15-103-02704-00-00

WELL RECORD

Company Cities Service Oil Co. Well No. 2 Farm Harrison "B"
 Location 330' North and 330' West of Center Sec. 28 T. 8 R. 16W
 Elevation 1943 (1940 Cr.) County Rooks State Kansas
 Drlg. Comm. November 17, 1949 Contractor Lohmann-Johnson Drilling Company
 Drlg. Comp. November 29, 1949 Acid None
 T. D. 3445' Initial Prod. None - Dry Hole. Plugged And Abandoned 11-29-49

CASING RECORD:

8-5/8" @ 301' cas. 175 wt cement

FORMATION RECORD:

rock & shale	0-220
shale	301
shale & sand	655
sand	900
shale & shells	1146
shale	1195
lime	1246
shale	1656
shale & shells	1756
broken lime	2162
lime & shale	2359
broken lime	2407
shale & shells	2614
broken lime	2707
lime & shale	2850
lime	2912
broken lime	2987
lime	3445 T. D.

Top Heebner	3035'
Top Dodge	3052'
Top Lansing	3070'
Top Arbuckle	3413'
Penetration	32'
Total Depth	3445'

SLOPE TESTS (ACID BOTTLE):

500'	0°
1000'	0°
1500'	1/2°
2000'	0°
2500'	0°
3000'	0°

7-7/8" rotary hole.

PLUGGING
 FILE SEC 28 T. 8 R. 16W
 BOOK PAGE 127 LINE 26

12-13-49

DEC 10 1949