

15-163-00270-00-00

STATE OF KANSAS
STATE CORPORATION COMMISSION


WELL PLUGGING RECORD

Give All Information Completely
Make Required Affidavit
Mail or Deliver Report to:
Conservation Division
State Corporation Commission
800 Bittling Building
Wichita, Kansas

OR
FORMATION PLUGGING RECORD

Strike out upper line
when reporting plug-
ging off formations.

NORTH

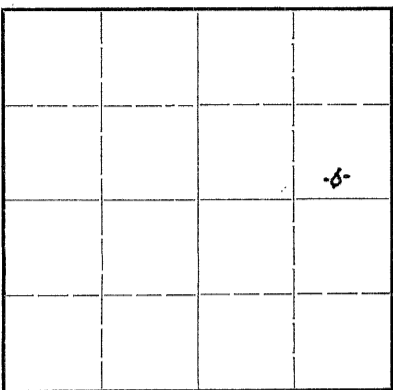

Locate well correctly on above
Section Plat

Rocks _____ County. Sec. 20 Twp. 8 Rge. (E) 16 (W)
Location as "NE $\frac{1}{4}$ NW $\frac{1}{4}$ SW $\frac{1}{4}$ " or footage from lines. C. S. $\frac{1}{2}$ SE $\frac{1}{2}$ NE $\frac{1}{2}$
Lease Owner The Derby Oil Company
Lease Name Brown Well No. 1
Office Address Wichita, Kansas
Character of Well (completed as Oil, Gas or Dry Hole) Dry Hole
Date well completed August 25 1945
Application for plugging filed by phone - August 25 1945
Application for plugging approved September 5 1945
Plugging commenced August 25 1945
Plugging completed August 25 1945
Reason for abandonment of well or producing formation
Dry Hole
If a producing well is abandoned, date of last production 19
Was permission obtained from the Conservation Division or its agents before plugging was com-
menced? Yes

Name of Conservation Agent who supervised plugging of this well H. W. Kerr
Producing formation None Depth to top _____ Bottom _____ Total Depth of Well 3393 Feet
Show depth and thickness of all water, oil and gas formations.

OIL, GAS OR WATER RECORDS


CASING RECORD

Formation	Content	From	To	Size	Put In	Pulled Out
				8 5/8"	245	None

Describe in detail the manner in which the well was plugged, indicating where the mud fluid was placed and the method or methods used in introducing it into the hold. If cement or other plugs were used, state the character of same and depth placed, from _____ feet to _____ feet for each plug set.

3593' to 235' Heavy mud
235' to 202' Wood plug & 15 sacks cement
202' to 25' Mud
25' to 6' Cement
6' to surface Earth

PLUGGING
FILE EC-20-8-R-164
BOOK PAGE 25 LINE 2

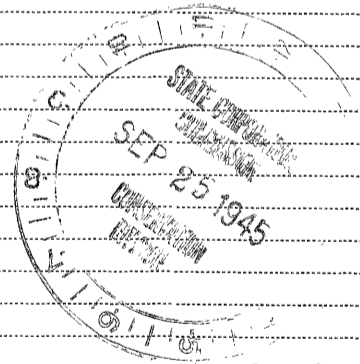

(If additional description is necessary, use BACK of this sheet)
Correspondence regarding this well should be addressed to The Derby Oil Company
Address Wichita, Kansas 9-25-45

STATE OF Kansas, COUNTY OF Sedgwick, ss.
S. E. Banks (employee of owner) or (owner or operator) of the above-described well,
being first duly sworn on oath, says: That I have knowledge of the facts, statements, and matters herein contained and the log of the above-described well as filed and that the same are true and correct. So help me God.

(Signature) S E Banks

Wichita, Kansas (Address)

SUBSCRIBED AND SWORN to before me this 24th day of September, 1945

My commission expires July 31, 1947

[Signature]
Notary Public.

Record of Well No. 1

Farm: Brown

Location: CS $\frac{1}{2}$ SE NE

Sec. 20 Twp. 8 Rge. 16W

Contractor: Glenn Peel

County: Rooks

Drilling Commenced: 8-9-45

State: Kansas

Elevation: 1849

Drilling Completed: 8-25-45

CASING RECORD:

8 5/8" set @ 245' w/125 sacks cement

Formation	Bottom	Formation	Bottom
Shale & Shells	0- 470		
Shale & Sand	530		
Shale	575		
Sand	585		
Shale	600		
Shale & Shells	792		
Sand	842		
Shale & Shells	1040		
Sand	1060		
Shale & Shells	1140		
Anhydrite	1185		
Shale & Shells	1580		
Shale & Lime	1608		
Shale	1620		
Lime	1695		
Lime - Broken	1825		
Shale & Lime	1946		
Broken Lime & Shale	2010		
Shale & Lime	2060		
Shale	2150		
Broken Lime & Shale	2235		
Shale & Shells	2297		
Lime & Shale	2429		
Broken Lime & Shale	2493		
Shale & Lime	2615		
Lime	2639		
Shale & Shells	2676		
Shale & Lime	2749		
Lime	3281		
Shale & Lime	3309		
Lime	3343		
Conglomerate	3374		
Arbuckle	3393		

GEOLOGICAL SURVEY

Tops:

Topeka	2754'
Lansing	2994'
Congl.	3342'
Arbuckle	3393'

Total Depth 3393'

No shows - D&A.

FILE NO. 20 8 16W
 3002 PAGE 25 LINE 2



9-25-45