

15-029-20005-00-00

FORM CP-4

STATE OF KANSAS  
STATE CORPORATION COMMISSION  
CONSERVATION DIVISION  
P. O. BOX 17027  
WICHITA, KANSAS 67317

WELL PLUGGING RECORD

CLOUD

County. Sec. 15 Twp. 8s Rge. 4 (W)

Location as "NE/CNW/SE/SW" or footage from lines 570'S. @ 1200'E. of the W 1/4 corner

Lease Owner Hi Rex Klump

Lease Name Wyett

Well No. CH #1

Office Address Raceland Farm - Star Route 10 - Box 786 - Hot Springs, Arkansas 71901

Character of Well (completed as Oil, Gas or Dry Hole) Abandoned core hole - Low.

Date well completed 6-29 1974

Application for plugging filed 7-1 1974

Application for plugging approved 7-1 1974


Plugging commenced 7-2 1974

Plugging completed 7-2 1974

Reason for abandonment of well or producing formation Client decided the core hole markers were running low

If a producing well is abandoned, date of last production 19

Was permission obtained from the Conservation Division or its agents before plugging was commenced? Yes

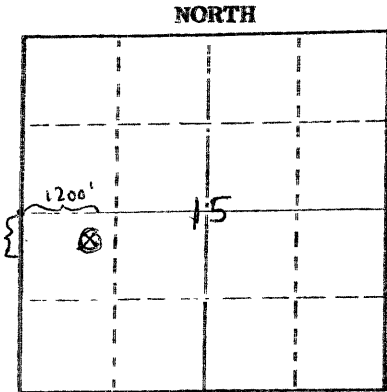

Locate well correctly on above Section Plat

Name of Conservation Agent who supervised plugging of this well Gilbert Tomlin's vacation replacement, Mr Hugh Scott was the representative

Producing formation None Depth to top None Bottom None Total Depth of Well 757 Core Hole

Show depth and thickness of all water, oil and gas formations.

OIL, GAS OR WATER RECORDS

CASING RECORD

FORMATION	CONTENT	FROM	TO	SIZE	PUT IN	PULLED OUT
<u>None</u>				<u>5 1/2"</u>	<u>26 ft</u>	<u>None</u>

RECEIVED  
STATE CORPORATION COMMISSION  
SEP 30 1974  
CONSERVATION DIVISION  
WICHITA, KANSAS

Describe in detail the manner in which the well was plugged, including where the mud fluid was placed and the method or methods used in introducing it into the hole. If cement or other plugs were used, state the character of same and depth placed, from 9-30-74 feet to 9-30-74 feet for each plug set.

An auto-plug bridge was set at 60 ft and 8 sacks of cement was pumped in from 60 ft to 5 ft from surface - then set to the surface

(If additional description is necessary, use BACK of this sheet)  
Name of Plugging Contractor Exploration, Inc. Permit #648  
Address 610 Petroleum Bldg - Wichita, Kansas 67202

STATE OF KANSAS COUNTY OF SEDGWICK  
BILL HAM Bill Ham Represent ss. of the above-described

well, being first duly sworn on oath, says: That I have knowledge of the facts, statements, and matters herein contained and the log of the above-described well as filed and that the same are true and correct. So help me God.

(Signature) Bill Ham  
610 Petroleum Bldg - Wichita, Kansas 67202  
(Address)

SUBSCRIBED AND SWORN TO before me this 25th day of September, 1974

Karen A. White

My commission expires \_\_\_\_\_

Notary Public.

KAREN A. WHITE  
STATE WIDE  
NOTARY PUBLIC  
Sedgwick County, Kansas  
My Comm. Exp. Nov. 23, 1975