

15-141-30003-00-00

STATE OF KANSAS  
STATE CORPORATION COMMISSION

Form CP-4

WELL PLUGGING RECORD

Give All Information Completely  
Make Required Affidavit  
Mail or Deliver Report to:  
Conservation Division  
State Corporation Commission  
211 No. Broadway  
Wichita, Kansas

Osborne County, Sec. 29 Twp. 8S Rge. 13 (E) (W)

Location as "NE/CNW/SW" or footage from lines C SE NE

Lease Owner Neven H. Veail

Lease Name Sarver Well No. 1

Office Address 1401 McKinley, Great Bend, Kansas

Character of Well (completed as Oil, Gas or Dry Hole) Dry Hole

Date well completed 7-7 19 66

Application for plugging filed 7-7 19 66

Application for plugging approved 7-7 19 66


Plugging commenced 7-7 19 66

Plugging completed 7-7 19 66

Reason for abandonment of well or producing formation Dry Hole

If a producing well is abandoned, date of last production 19

Was permission obtained from the Conservation Division or its agents before plugging was commenced? Yes

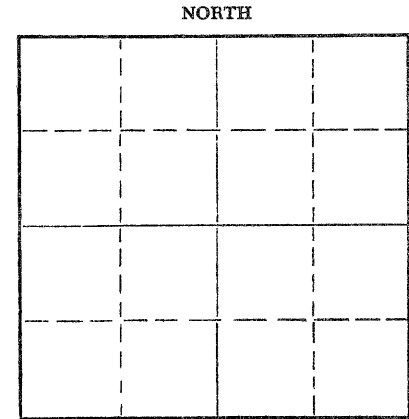

Locate well correctly on above  
Section Plat

Name of Conservation Agent who supervised plugging of this well Don Truan

Producing formation \_\_\_\_\_ Depth to top \_\_\_\_\_ Bottom \_\_\_\_\_ Total Depth of Well \_\_\_\_\_ Feet

Show depth and thickness of all water, oil and gas formations.

OIL, GAS OR WATER RECORDS

CASING RECORD

FORMATION	CONTENT	FROM	TO	SIZE	PUT IN	PULLED OUT

Describe in detail the manner in which the well was plugged, indicating where the mud fluid was placed and the method or methods used in introducing it into the hole. If cement or other plugs were used, state the character of same and depth placed, from \_\_\_\_\_ feet to \_\_\_\_\_ feet for each plug set.

3840' - 185' - Heavy rotary mud  
185' - HB plug, 25 sacks cement  
185' - 40' - Heavy rotary mud  
40' - GL - HB plug, 10 sacks cement

RECEIVED  
STATE CORPORATION COMMISSION

JUL 18 1966

CONSERVATION DIVISION  
Wichita, Kansas

Name of Plugging Contractor Peel Brothers, Inc. (If additional description is necessary, use BACK of this sheet)  
Address Box 359, Hoisington, Kansas 67544 7-18-66

STATE OF Kansas, COUNTY OF Barton, ss. Peel Brothers, Inc. (employee of owner) of the above-described

well, being first duly sworn on oath, says: That I have knowledge of the facts, statements, and matters herein contained and the log of the above-described well as filed and that the same are true and correct. So help me God. PEEL BROTHERS, INC.

(Signature) Jack Mattocks  
W. E. "Jack" Mattocks  
Drilling Superintendent  
(Address)

SUBSCRIBED AND SWORN TO before me this 12th day of July, 19 66

My commission expires 6-21-70  
Ethel S. Williamson  
Ethel S. Williamson Notary Public.