


15-141-00035-00-00

Give All Information Completely  
Make Required Affidavit  
Mail or Deliver Report to:  
Conservation Division  
State Corporation Commission  
800 Bitting Building  
Wichita, Kansas

WELL PLUGGING RECORD

NORTH

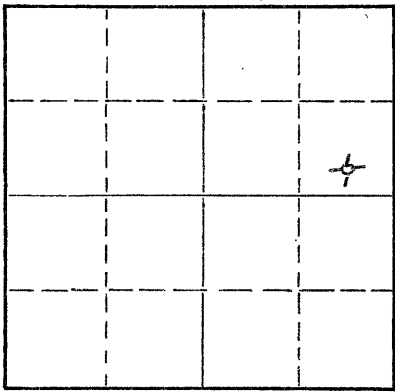

Locate well correctly on above  
Section Plat

Osborne County. Sec. 25 Twp. 8S Rge. 13 (E) W (W)  
Location as "NE/CNW/SW" or footage from lines C S/2 SE/4 NE/4  
Lease Owner Markan Incorporated  
Lease Name Enocks Well No. 1  
Office Address P.O. Box 1110, Wichita Falls, Texas  
Character of Well (completed as Oil, Gas or Dry Hole) Dry Hole  
Date well completed Sept. 5 1954  
Application for plugging filed Sept. 5 1954  
Application for plugging approved Sept. 5 1954  
Plugging commenced Sept. 5 1954  
Plugging completed Sept. 5 1954  
Reason for abandonment of well or producing formation Dry hole

If a producing well is abandoned, date of last production 19  
Was permission obtained from the Conservation Division or its agents before plugging was commenced? Yes

Name of Conservation Agent who supervised plugging of this well  
Producing formation Depth to top Bottom Total Depth of Well 4162 Feet  
Show depth and thickness of all water, oil and gas formations.

OIL, GAS OR WATER RECORDS

CASING RECORD

FORMATION	CONTENT	FROM	TO	SIZE	PUT IN	PULLED OUT
		0	155'	8 5/8"	155'	None

Describe in detail the manner in which the well was plugged, indicating where the mud fluid was placed and the method or methods used in introducing it into the hole. If cement or other plugs were used, state the character of same and depth placed, from feet to feet for each plug set.

From 4162' to 161 1/2' - heavy rotary mud  
161 1/2' to 160' - wooden plug  
160' to 114' - 15 sacks cement and 1 sack hulls  
114' to 36 1/2' - heavy rotary mud  
36 1/2' to 35' - wooden plug  
35' to 6' - 10 sacks cement  
6' to surface - cellar

(If additional description is necessary, use BACK of this sheet)

Name of Plugging Contractor Glenn W. Peel  
Address P.O. Box 359, Hoisington, Kansas

STATE OF KANSAS, COUNTY OF BARTON, ss.  
Glenn W. Peel (employee of owner) or (owner or operator) of the above-described well, being first duly sworn on oath, says: That I have knowledge of the facts, statements, and matters herein contained and the log of the above-described well as filed and that the same are true and correct. So help me God.

(Signature) BY: *Glenn W. Peel*  
P.O. Box 359, Hoisington, Kansas  
(Address)

SUBSCRIBED AND SWORN TO before me this 8th day of September, 1954

My commission expires June 4, 1955

*Marion McHerbert*  
Notary Public.

PLUGGING  
FILE SEC 25 T 8 R 13W  
BOOK PAGE 12 LINE 12

9-11-54

DRILLERS' LOG

Company: Merkan Incorporated

C S/2 SE/4 NE/4  
Sec. 25, Twp. 8S, Rge 13W

Farm Name: Knocks Well No. 1

County: Osborne,  
Kansas

Total Depth: 4162'

Comm: 8-22-54 Comp: 9-5-54  
Contractor: Glenn W. Peel

Elevation:

Production: Dry

Casing: 8 5/8" 155' cem.

Figures below indicate bottoms of formations:

Surface rock	0 -	40
Shale		620
Shale and sand		950
Shale		1030
Anhydrite		1065
Shale		1125
Shale and shells		1550
Lime		1745
Lime and shale		2855
Lime		3030
Lime and shale		3110
Lime		3609
Lime and shale		3680
Lime		3691
Chert		3720
Lime		3815
Shale		3860
Lime		4162
Total Depth		4162

This is to certify that the above information is to the best of our knowledge, true and correct.

GLENN W. PEEL

BY: Wm Herbert

SUBSCRIBED AND SWORN to before me this 8<sup>th</sup> day of September, 1954.

My commission expires: June 4, 1955.

Marion M. Herbert  
Notary Public

**PLUGGING**  
FILE SEC 25 T 8 R 13W  
BOOK PAGE 02 LINE 12

9-11-54