

CARD MUST BE TYPED

STATE OF KANSAS  
**NOTICE OF INTENTION TO DRILL**  
(see rules on reverse side)

CARD MUST BE SIGNED

Starting Date: ..... 10 ..... 19 ..... 84 .....  
month day year

API Number 15- 059-23,758 -00-00

OPERATOR: License # 6109 .....

NE/4 ..... Sec 32 Twp 17 S. Rge 21  East  
(location) .....  West

Name C.F. OIL .....

Address c/o Gerald Frazier R#1 R-40 .....

City/State/Zip Lake Lotawana, Mo. 64063 .....

Contact Person Jerry or Janet Frazier .....

Phone 816-578-4308 .....

4785 ..... Ft North from Southeast Corner of Section  
1815 ..... Ft West from Southeast Corner of Section  
(Note: Locate well on Section Plat on reverse side)

CONTRACTOR: License # 5353 .....

Name Bloomer Well Service .....

City/State Box 40 Rantoul, Ks. 66079 .....

Nearest lease or unit boundary line ..... 165 ..... feet.

County Franklin .....

Lease Name McClellan ..... Well# 6 .....

Domestic well within 330 feet:  yes  no

Municipal well within one mile:  yes  no

Well Drilled For: Well Class: Type Equipment:

- Oil  Swd  Infield  Mud Rotary
- Gas  Inj  Pool Ext.  Air Rotary
- OWWO  Expi  Wildcat  Cable

Depth to Bottom of fresh water ..... none ..... feet

Lowest usable water formation .....

Depth to Bottom of usable water ..... 250 ..... feet

Surface pipe by Alternate: 1  2

Surface pipe to be set into solid formation 20. feet

Conductor pipe if any required .....

Ground surface elevation ..... 1010 ..... feet MSL

This Authorization Expires 4/17/85 .....

Approved By RCA/KC 10/17/84 .....

If OWWO: old well info as follows:

Operator .....

Well Name .....

Comp Date ..... Old Total Depth .....

Projected Total Depth 850 ..... feet

Projected Formation at Squirrel &/or Cattleman .....

Expected Producing Formations !! .....

I certify that we will comply with K.S.A. 55-101, et seq., plus eventually plugging hole to K.C.C. specifications.

Date 10/13/84 ..... Signature of Operator or Agent


Janet Frazier .....

Title secy ..... MHC/KC/HE 10/17/84

Must be filed with the K.C.C. five (5) days prior to commencing well  
This card void if drilling not started within six (6) months of date received by K.C.C.

**Important procedures to follow:**

**A Regular Section of Land**  
**1 Mile = 5,280 Ft.**

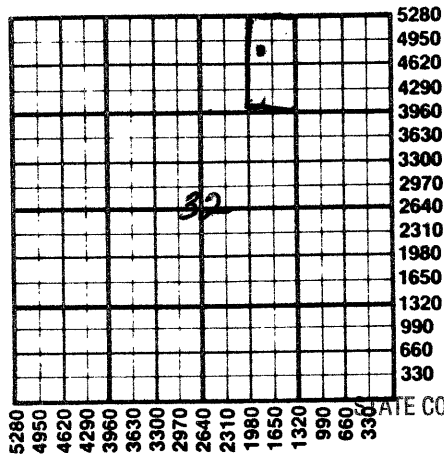

1. Notify District office before setting surface casing.
2. Set surface casing by circulating cement to the top.
3. File completion forms ACO-1 with K.C.C. within 90 days of well completion, following instructions on ACO-1, side 1, and including copies of wireline logs.
4. Notify District office 48 hours prior to old well workover or re-entry.
5. Prior to plugging, prepare a plugging plan, then obtain agreement from the appropriate district office for an approved plugging plan.
6. Submit plugging report (CP-4) to K.C.C. after plugging is completed.
7. Obtain an approved injection docket number before disposing of salt water.
8. Notify K.C.C. within 10 days when injection commences or terminates.
9. If an alternate 2 completion, cement in the production pipe from below any usable water to surface within 120 days of spud date.

RECEIVED  
STATE CORPORATION COMMISSION

State Corporation Commission of Kansas  
Conservation Division  
200 Colorado Derby Building  
Wichita, Kansas 67202  
(316) 263-3238

OCT 17 1984  
CONSERVATION DIVISION  
Wichita, Kansas

10-17-84