

Notice: Fill out COMPLETELY
and return to Conservation Division
at the address below within
60 days from plugging date.

KANSAS CORPORATION COMMISSION
OIL & GAS CONSERVATION DIVISION
WELL PLUGGING RECORD
K.A.R. 82-3-117

Form CP-4
December 2003
Type or Print on this Form
Form must be Signed
All blanks must be Filled

Lease Operator: XTO Energy, Inc.
Address: 210 Park Ave., Ste. 2350 OKC, OK 73102
Phone: (405) 319-3212 Operator License #: 32864
Type of Well: Gas Docket #: _____
(Oil, Gas D&A, SWD, ENHR, Water Supply Well, Cathodic, Other) (If SWD or ENHR)
The plugging proposal was approved on: 6-7-06 (Date)
by: Ken Jehlik (KCC District Agent's Name)
Is ACO-1 filed? Yes No If not, is well log attached? Yes No
Producing Formation(s): List All (If needed attach another sheet)
Council Grove Depth to Top: 2724 Bottom: 2846 T.D. 3010
_____ Depth to Top: _____ Bottom: _____ T.D. _____
_____ Depth to Top: _____ Bottom: _____ T.D. _____

API Number: 15-093-20352-00-00
Lease Name: Masonic Home
Well Number: 3-2
Spot Location (QQQQ): NE-NE-NE-SW
2520 Feet from North / South Section Line
2540 Feet from East / West Section Line
Sec. 36 Twp. 25 S. R. 36 East West
County: Kearny
Date Well Completed: 11-24-76 spud
Plugging Commenced: 6-13-06
Plugging Completed: 6-14-06

Show depth and thickness of all water, oil and gas formations.


Oil, Gas or Water Records		Casing Record (Surface Conductor & Production)				
Formation	Content	From	To	Size	Put In	Pulled Out
		0	535	8 5/8	535	-
		0	3008'	5 1/2	2999	837

Describe in detail the manner in which the well is plugged, indicating where the mud fluid was placed and the method or methods used in introducing it into the hole. If cement or other plugs were used, state the character of same depth placed from (bottom), to (top) for each plug set.
Mixed 400 lb. hulls + 20 sx cmt to plug perfs from 2724 to 2524,
mud spacer to 1850, 20 sx 1850 to 1650, mud to 0. Pull 5 1/2 to
650 Circ. hole w/mud, 50 sx 650 to 500, 10 sx 40 to 0
Capped 8 5/8 3 ft. below G.L.

Name of Plugging Contractor: SARGENT AND HORTON PLUGGING, INC. License #: 31151
Address: Rt. 1, Box 49 BA Tyrone, OK 73951-9731
Name of Party Responsible for Plugging Fees: XTO Energy, Inc.
State of Oklahoma County, Oklahoma, ss.

Karen Byers (Employee of Operator) or (Operator) on above-described well, being first duly sworn on oath, says: That I have knowledge of the facts statements, and matters herein contained, and the log of the above-described well is as filed, and the same are true and correct, so help me God.
(Signature) Karen Byers
(Address) 210 Park Ave., Ste 2350, OKC, OK 73102

SUBSCRIBED and SWORN TO before me this 26 day of June, 20 06
R. Southward Notary Public My Commission Expires: _____

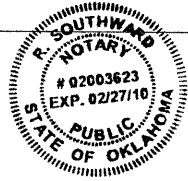

RECEIVED
JUN 28 2006
KCC WICHITA

Mail to: KCC - Conservation Division, 130 S. Market - Room 2078, Wichita, Kansas 67202

PKT

12-8-76

DATE

Kearney 36 25s 36w 2520'FSL 2540FWL


COUNTY S T R LOCATION

Kansas-Nebraska 3-2 Masonic Home

OPERATOR NO. FARM

ELEVATION: 3041 gr.

SCALE: 2"=1mile

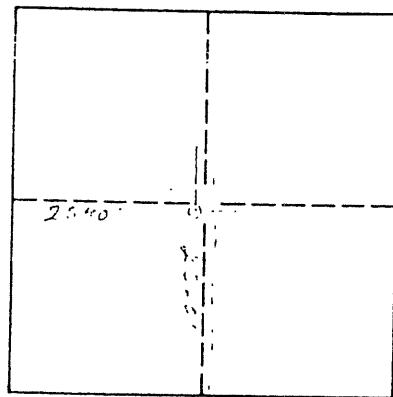

Please Note this is Restake on this Location as request by Dan REINEKE

MINIMUM STAKING CHARGE: \$85.00
(INCLUDES GROUND ELEVATION)

EXTRA TIME & MILEAGE: _____

ELEVATION CHARGE: _____

TOTAL: \$85.00

Vernon C Becker
L-S SURVEYOR

Laughlin-Simmons & Co. of Kansas, Inc. is not liable in case of errors and/or omissions.

RECEIVED
JUN 28 2006
KCC WICHITA