

**CARD MUST BE SIGNED**

## NOTICE OF INTENTION TO DRILL

(see rules on reverse side)

Expected Spud Date.....Unknown.....  
month      day      year

API Number 15— 059-24,397-00-00

OPERATOR: License # 09098

NE-NE-SW ..... Sec. 12 Twp. 18S S, Rg 20E ..... West

Name McConathy Production Co., Inc.

2310'..... Ft. from South Line of Section

Address 509 Market St., Suite 200

2970' ..... Ft. from East Line of Section

City/State/Zip Shreveport, LA 71101

(Note: Locate well on Section Plat on reverse side)

Contact Person.....Terry W. Buck

Nearest lease or unit boundary line ..... 330 ..... feet

Phone 318/227-1498

County.....Franklin.....

**CONTRACTOR:** License # .....

Lease Name Albert Ranch..... Well # 2.....

Name .....Unknown.....

Ground surface elevation 1060.....feet MSI

City/State .....

Ground surface elevation 1060.....feet MSI

Well Drilled For: Well Class: Type Equipment:

Domestic well within 330 feet:       yes   X  no

\_\_\_ Oil      \_\_\_ Storage      \_\_\_ Infield      \_\_\_ Mud Rotary

Municipal well within one mile: ☐ yes ☒ no

$\frac{X}{\text{Gas}}$        $\frac{X}{\text{Ini}}$        $\frac{X}{\text{Pool Ext.}}$        $\frac{X}{\text{Air Rotary}}$

Depth to bottom of fresh water. 40' ~~Unknown~~

☒ OWWO    ☐ Expl    ☐ Wildcat    ☐ Cable

Depth to bottom of usable water ..... 200 .....

**If OWWO:** old well info as follows:

Surface pipe by Alternate: 1 2 X

Operator .....

Surface pipe planned to be set ..... 21'

Well Name .....

Conductor pipe required ..... None

Comp Date ..... Old Total Depth.....

Projected Total Depth ..... 800' ..... feet

I certify that well will comply with K.S.A. 55-101, et seq., plus eventually plugging hole to KCC specifications.

Formation.....Squirrel-Peru.....

Date July 20, 1988 Signature of Operator or Agent Derry W. Bush Title Vice President

**For KCC Use:**

Conductor Pipe Required .....feet; Minimum Surface Pipe Required .....<sup>20'</sup>feet per Alt. **N** (2)

This Authorization Expires 5-7-89 Approved By LKM 11-7-88


~~EFFECTIVE DATE:~~ 11-12-88

Must be filed with the K.C.C. five (5) days prior to commencing well  
This card void if drilling not started within six (6) months of date received by K.C.C.

**Important procedures to follow:**

1. Notify District office before setting surface casing.
2. Set surface casing by circulating cement to the top.
3. File completion forms ACO-1 with K.C.C. within 120 days of well spud date, following instructions on ACO-1, side 1, and including copies of wireline logs.
4. Notify District office 48 hours prior to old well workover or re-entry.
5. Prior to filing Intent, prepare a proposed plugging plan in case well is D & A, then obtain approval of plan when calling district office prior to setting surface pipe.
6. Submit plugging report (CP-4) to K.C.C. after plugging is completed.
7. Obtain an approved injection docket number before disposing of salt water.
8. Notify K.C.C. within 10 days when injection commences or terminates.
9. In alternate 2 completion, cement in the production pipe from casing any usable water to surface within 120 days of spud date.

**A Regular Section of Land**  
**1 Mile = 5,280 Ft.**

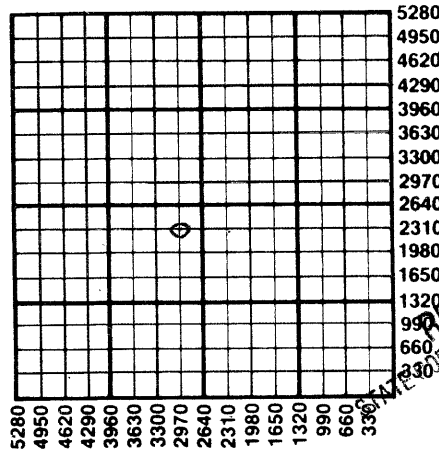

State Corporation Commission of Kansas  
Conservation Division  
200 Colorado Derby Building  
Wichita, Kansas 67202-1212  
(316) 263-3238