

CARD MUST BE TYPED

State of Kansas

CARD MUST BE SIGNED

NOTICE OF INTENTION TO DRILL

(see rules on reverse side)

Expected Spud Date... As soon as possible
month day year

API Number 15— 059-24,298 -00-000

OPERATOR: License # 8794
Name James F. Savage
Address R.R. #1 Box 106
City/State/Zip Rantoul, Ks. 66079
Contact Person Judith A. Savage
Phone (913) 878-3421

E $\frac{1}{2}$ of NW $\frac{1}{4}$ Sec. 5 Twp. 18 S, Rg. 21 East
3200 Ft. from South Line of Section
3800 Ft. from East Line of Section

(Note: Locate well on Section Plat on reverse side)

CONTRACTOR: License # 8509
Name Evans Energy Development Inc.
City/State Ottawa, Ks. 66067

Nearest lease or unit boundary line 1160 feet
County Franklin

Lease Name SAVAGE Well # 33
Ground surface elevation feet MSL

Well Drilled For: Well Class: Type Equipment:
 Oil Storage Infield Mud Rotary
 Gas Inj. Pool Ext. Air Rotary
 OWWO Expl Wildcat Cable

Domestic well within 330 feet: yes no
Municipal well within one mile: yes no
Depth to bottom of fresh water: 200'
Depth to bottom of usable water: 75
Surface pipe by Alternate: 1 2
Surface pipe planned to be set 20'
Conductor pipe required none
Projected Total Depth 650 feet
Formation squirrel

If OWWO: old well info as follows:
Operator
Well Name
Comp Date Old Total Depth

I certify that well will comply with K.S.A. 55-101, et seq., plus eventually plugging hole to KCC specifications.
Date 1-2-88 Signature of Operator or Agent James F. Savage Title operator

For KCC Use:
Conductor Pipe Required feet; Minimum Surface Pipe Required feet per Alt. 20 2
This Authorization Expires 7-4-88 Approved By RLH 1-4-88


EXPIRES DATE: 1-9-88

Must be filed with the K.C.C. five (5) days prior to commencing well
This card void if drilling not started within six (6) months of date received by K.C.C.

Important procedures to follow:

1. Notify District office before setting surface casing.
2. Set surface casing by circulating cement to the top.
3. File completion forms ACO-1 with K.C.C. within 120 days of well spud date, following instructions on ACO-1, side 1, and including copies of wireline logs.
4. Notify District office 48 hours prior to old well workover or re-entry.
5. Prior to filing Intent, prepare a proposed plugging plan in case well is D & A, then obtain approval of plan when calling district office prior to setting surface pipe.
6. Submit plugging report (CP-4) to K.C.C. after plugging is completed.
7. Obtain an approved injection docket number before disposing of salt water.
8. Notify K.C.C. within 10 days when injection commences or terminates.

**A Regular Section of Land
1 Mile = 5,280 Ft.**

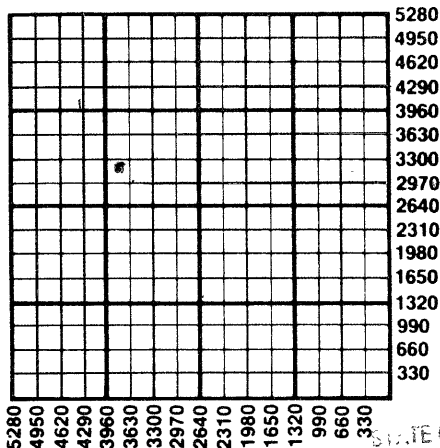

RECEIVED
STATE CORPORATION COMMISSION

JAN 04 1988

CONSERVATION DIVISION
Wichita, Kansas
1-4-88

9. If an alternate 2 completion, cement in the production pipe from below any usable water to surface within 120 days of spud date.

State Corporation Commission of Kansas
Conservation Division
200 Colorado Derby Building
Wichita, Kansas 67202-1212
(316) 263-3238