

CARD MUST BE TYPED

State of Kansas
NOTICE OF INTENTION TO DRILL
(see rules on reverse side)

CARD MUST BE SIGNED

Starting Date: 6/7/85
month day year 3:50

OPERATOR: License # 5688
Name Pioneer Petroleum, Inc,
Address 116 A W. 3rd St.
City/State/Zip Ottawa, KS 66067
Contact Person George Sell
Phone 913-242-4499

CONTRACTOR: License # 6913
Name Casady Drilling Co.
City/State Ottawa, KS 66067

Well Drilled For: Well Class: Type Equipment:
 Oil Swd Infield Mud Rotary
 Gas Inj Pool Ext. Air Rotary
 OWWO Expl Wildcat Cable

If OWWO: old well info as follows:
Operator
Well Name
Comp Date 750 Old Total Depth
Projected Total Depth feet
Projected Formation at TD
Expected Producing Formations

I certify that we will comply with K.S.A. 55-101, et seq., plus eventually plugging hole to K.C.C. specifications.

Date 6/4/85
Signature of Operator or Agent *Susan Arnold*

API Number 15- 059-23918-0000

NW NE SE East
..... See 4 Twp 18 S, Rge 21 West
..... 2315 Ft North from Southeast Corner of Section
..... 1180 Ft West from Southeast Corner of Section
(Note: Locate well on Section Plat on reverse side)

Nearest lease or unit boundary line 165 feet.
County Franklin
Lease Name Gilchrist Well# 5P

Domestic well within 330 feet : yes no
Municipal well within one mile : yes no

Depth to Bottom of fresh water none feet
Lowest usable water formation
Depth to Bottom of usable water 200 feet
Surface pipe by Alternate : 1 2
Surface pipe to be set 21 feet
Conductor pipe if any required feet
Ground surface elevation feet MSL
This Authorization Expires 12-4-85
Approved By 6-4-85 *[Signature]*


As Agent
Title

MHC/KOHE 6-4-85
Form C-1 4/84

Must be filed with the K.C.C. five (5) days prior to commencing well
 This card void if drilling not started within six (6) months of date received by K.C.C.

Important procedures to follow :

**A Regular Section of Land
 1 Mile = 5,280 Ft.**

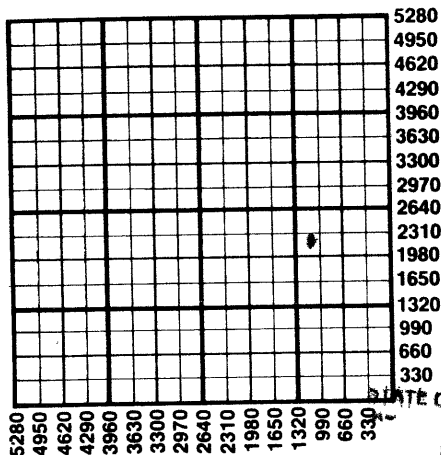

1. Notify District office before setting surface casing.
2. Set surface casing by circulating cement to the top.
3. File completion forms ACO-1 with K.C.C. within 90 days of well completion, following instructions on ACO-1, side 1, and including copies of wireline logs.
4. Notify District office 48 hours prior to old well workover or re-entry.
5. Prior to plugging, prepare a plugging plan, then obtain agreement from the appropriate district office for an approved plugging plan.
6. Submit plugging report (CP-4) to K.C.C. after plugging is completed.
7. Obtain an approved injection docket number before disposing of salt water.
8. Notify K.C.C. within 10 days when injection commences or terminates.
9. If an alternate 2 completion, cement in the production pipe from below by usable water to surface within 120 days of spud date.

RECEIVED
 STATE CORPORATION COMMISSION

State Corporation Commission of Kansas
 Conservation Division
 200 Colorado Derby Building
 Wichita, Kansas 67202
 (316) 263-3238

JUN 4 1985

CONSERVATION DIVISION
 Wichita, Kansas

64-85